

Jackson  
 J 148  
 5-12-75

MISSISSIPPI  
 BOARD OF WATER COMMISSIONERS  
 416 North State Street  
 Jackson, Mississippi 39201

CODED

WATER WELL DRILLERS LOG

COASTAL DRILLING & SERVICE CO. Jackson

5/12/75  
 date well completed

ROUTE 1 BOX 618  
 company name

county well located

LANDOWNER: Bob Applewhite

MISS. 39532  
 state information encountered

from to

Lester Cunn  
 Clear Spring Miss  
 (mailing address)

top soil	1	3
Red Clay	3	15
White Sand	15	65
Soft Blue Clay	65	200
hard clay	200	210
Coarse water sand	210	245

WELL LOCATION:

sec 14 T 4 N R 9 E 13 S  
 S W  
 Lester Cunn  
 (distance) (direction) (nearest town)

WELL PURPOSE: Home  
 (home, irrigation, municipal, industrial)

WELL COMPLETION DATA:

- (1) diameter (inches) 2"
- (2) total depth (feet) 245'
- (3) static water level (feet) 6 below top of ground
- (4) casing PVC 245'  
 (material) (depth)  
 (size) if telescope see back.
- (5) screen 10' 235'  
 (length) (depth to top)  
 2" PVC  
 (size) (material)
- (6) pump One 20  
 (HP) (yield gpm)  
 Ele Sup  
 (type power)
- (7) electric log no  
 (yes or no)  
 (organization running log)


(8) how well bottom plugged  
 24 feet and below

DRILLERS REMARKS:

RECEIVED  
 JUL 17 1975

If well telescopes please sketch and show depths.

GROUND LEVEL

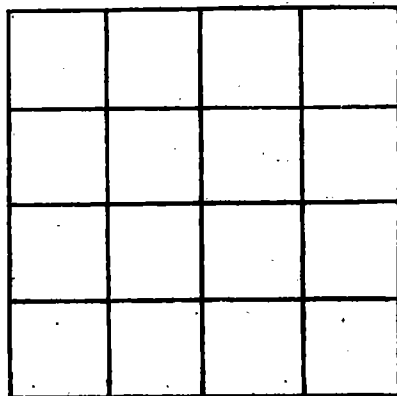

SECTION \_\_\_\_\_

Please indicate well location X.

ADDITIONAL INFORMATION

If more than one screen, show locations of each on sketch.