

MISSISSIPPI DEPARTMENT OF NATURAL RESOURCES
 Bureau of Land and Water Resources
 Southport Mall
 P.O. Box 10631

CODED

Jackson, Mississippi 39209
 WATER WELL DRILLERS LOG

JACKSON
 J 150
 10-24-80

Oct. 24 1980 date well completed
 80 Duncan Well Drilling Jackson firm name
 county well located

LANDOWNER: W. E. Romanovsky
15000 Crutcher's Rd.
Ocean Springs, Ms 39564
 (mailing address)

WELL LOCATION:
 sec. 23 T 6 N R 9 E
5 1/2 miles (distance) S (direction) of Stennis (nearest town)

WELL PURPOSE: Same
 (home, irrigation, municipal, industrial)

WELL COMPLETION DATA:

- (1) diameter (inches) 2"
- (2) total depth (feet) 1071 1/2
- (3) static water level (feet) 6 below top of ground.
- (4) casing PVC (material), 1071" (depth)
- (5) screen 10' (length), 1061' (depth to top)
2" (size), PVC (material)
- (6) pump 1 (HP), 25 (yield gpm)
electric (type power)
- (7) electric log (yes or no) _____

(organization running log) _____
 (8) how well bottom plugged Sand
Mark

description of formations encountered	from	to
Clay	0	40
Sand	40	60
Blue Clay	60	200
Fine Sand	200	265
Blue Clay	265	350
Fine Sand	350	410
Blue Clay	410	800
Fine Sand	800	850
Blue Clay	850	980
Fine Sand	980	1050
Course Sand	1050	1071

DEPT. OF NATURAL RESOURCES
 BUREAU OF LAND & WATER RESOURCES


OCT 31 1980

RECEIVED

DRILLERS REMARKS: _____

If well telescopes please sketch and show depths.

GROUND LEVEL

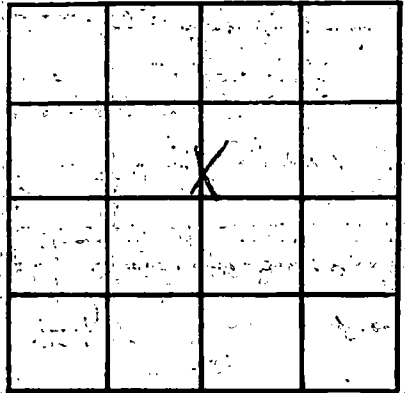

SECTION 23

Please indicate well location 'X'.

ADDITIONAL INFORMATION

Multiple horizontal lines for additional information.

RECEIVED
If more than one screen, show locations of each on sketch.