

MISSISSIPPI DEPARTMENT OF NATURAL RESOURCES

Bureau of Land and Water Resources

Southport Mall

P.O. Box 10631

Jackson, Mississippi 39205

WATER WELL DRILLERS LOG

JACKSON
J 151
10/24/80

Oct. 24 1980
date well completed

80 Newcom Well Drilling
firm name

Jackson
county well located

CODED

LANDOWNER: Judy Deman

15000 Cuttricks Rd.
Ocean Springs, Ms.
(mailing address)

description of formations encountered

from

to

WELL LOCATION:

sec. 23 T-6 N R-9 E
6 miles (distance) N (direction) of Ocean Springs (nearest town)

Sand	0	80
Clay	80	200
fine Sand	200	243
Blue Clay	243	700
thick Blue Clay + Sand	700	998
fine Sand	998	1050
Course Sand	1050	1071

WELL PURPOSE: home
(home, irrigation, municipal, industrial)

WELL COMPLETION DATA:

- diameter (inches) 2"
- total depth (feet) 1071 ft.
- static water level (feet) 10' above top of ground. above
- casing PVC (material), 1061 (depth)
If telescope see back. (size)
- screen 10 (length), 1061 (depth to top)
2" (size), PVC (material)
- pump 1 (HP), 25 (yield gpm)
electric (type power)
- electric log (yes or no) _____

CODED

(organization running log)

(8) how well bottom plugged Sand
Shank

DEPT. OF NATURAL RESOURCES
BUREAU OF LAND & WATER RESOURCES


MAR 18 1981

DRILLERS REMARKS:

RECEIVED

If well telescopes please sketch and show depths.

GROUND LEVEL

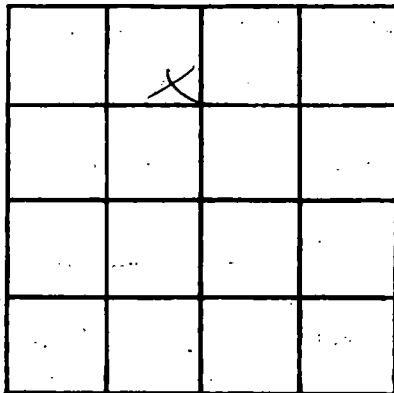

SECTION 23

Please indicate well location X.

ADDITIONAL INFORMATION

If more than one screen, show locations of each on sketch.