

MISSISSIPPI DEPARTMENT OF NATURAL RESOURCES  
Bureau of Land and Water Resources

Southport Mall  
P.O. Box 10631

Jackson, Mississippi 39209  
WATER WELL DRILLERS LOG

CODED

JACKSON  
J155  
1-5-84

1-5-84 19 Coast Water Well Sew. Jackson  
date well completed firm name county well located

OWNER: Christ The King Catholic Church  
LANDOWNER: Rt 4 Box 111A -  
Osun Springs, Miss.  
(mailing address) 37564

WELL LOCATION:  
sec. 27 T. 6 S. R. 9 W.  
3 miles (distance) S of LATIMER (direction) (nearest town)

WELL PURPOSE: Church  
(home, irrigation, municipal, industrial)

WELL COMPLETION DATA:  
(1) diameter (inches) 2"  
(2) total depth (feet) 311'  
(3) static water level (feet) 93' below top of ground. change  
(4) casing PVC 301'  
(material) (depth)  
2" if telescope see back.  
(size)  
(5) screen 10' 301'  
(length) (depth to top)  
2" PVC  
(size) (material)  
(6) pump 2h.p. 8 1/2"  
(HP) (yield gpm)  
check.  
(type power)  
(7) electric log No.  
(yes or no)  
—  
(organization running log)  
(8) how well bottom plugged  
back wash valve

Description of formations encountered	from	to
Top soil	0	5'
Red Clay	5	10'
White Clay	10	16'
Blue Clay & streak of sand	16	37'
Red Coarse sand		
Wood & gravel	37	52'
Blue Clay	52	284'
Grey Coarse sand	284	301'
Blue Clay	301	311'
2" x 10" Tail Pipe		

DEPT. OF NATURAL RESOURCES  
BUREAU OF LAND & WATER RESOURCES


MAR -1 1984

RECEIVED

DRILLERS REMARKS:

If well telescopes please sketch and show depths.

GROUND LEVEL

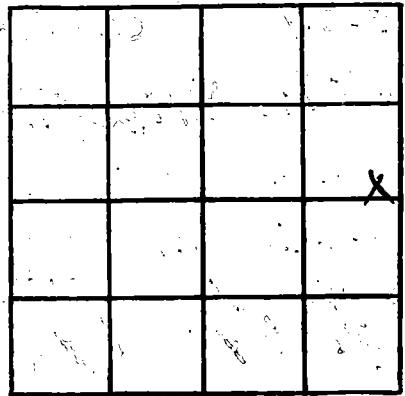

SECTION 27

Please indicate well location X.

ADDITIONAL INFORMATION

If more than one screen, show locations of each on sketch.