

MISSISSIPPI DEPARTMENT OF NATURAL RESOURCES

Bureau of Land and Water Resources

Southport Mall

P.O. Box 10631

CODED

Jackson, Mississippi 39209

WATER WELL DRILLERS LOG

JACKSON
J 157
4/4/84

4/4/84 19

Lyman Well Co.

Harvey Jackson

date well completed

firm name

county well located

LANDOWNER: Robert Bowers
15101 Glendale
Ocean Springs, MS
(mailing address)

| description of formations encountered | from | to |
|---------------------------------------|------|-----|
| Blue Lumbd | 0 | 85 |
| Blue Lumbd & Grey Clay | 85 | 170 |
| Blue Clay | 170 | 260 |
| Fine Sand | 260 | 290 |
| Blue Clay | 290 | 375 |
| Hard Sand | 375 | 408 |

WELL LOCATION:
sec. 13 T. 6 N. R. 9 E
12 miles N/W of Ocean Springs
(distance) (direction) (nearest town)

WELL PURPOSE: HOME
(home, irrigation, municipal, industrial)

WELL COMPLETION DATA:

(1) diameter (inches) 2"

(2) total depth (feet) 408'

(3) static water level (feet) 70' below top of ground

(4) casing PVC 398'
(material) (depth)

2" If telescope see back.
(size)

(5) screen 10' 398'
(length) (depth to top)

2" PVC
(size) (material)

(6) pump 1 8
(HP) (yield gpm)

electric
(type power)

(7) electric log No
(yes or no)

No
(organization running log)

(8) how well bottom plugged Sand
Shack

CODED

DEPT. OF NATURAL RESOURCES
BUREAU OF LAND & WATER RESOURCES


SEP - 5 1984

RECEIVED

DRILLERS REMARKS:

If well telescopes please sketch and show depths.

GROUND LEVEL

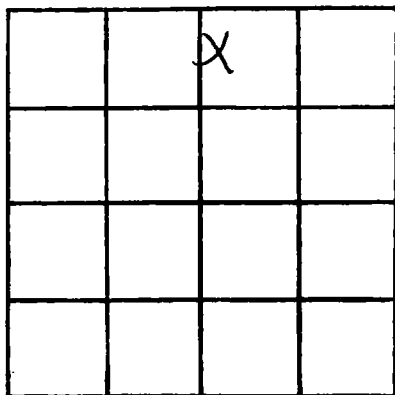

SECTION 13

Please indicate well location X.

ADDITIONAL INFORMATION

If more than one screen, show locations of each on sketch.