

JACKSON
J 158

MISSISSIPPI DEPARTMENT OF NATURAL RESOURCES

Bureau of Land and Water Resources

Southport Mall

P.O. Box 10631

Jackson, Mississippi 39209 CODED

COASTAL WATER WELL DRILLERS LOG

ROUTE 1 BOX 618

BILOXI, MISS. firm name 39537

Jackson county well located

11/4/83
date well completed

LANDOWNER Harry Poloss

14220 Glenn Rd

Ocean Springs MS
(mailing address)

description of formations encountered	from	to
Top Soil	1	3
Sand + Red Clay	3	18
Coarse white Sand	18	40
Soft Blue Clay	40	210
fine water sand	210	230
Hard Blue Clay	230	250
fine blue sand	250	440
good water sand	410	440

WELL LOCATION:

sec 27 T 6 N R 9 E
W 1/4
Wave South Lakeview
(distance) (direction) (nearest town)

WELL PURPOSE: home
(home, irrigation, municipal, industrial)

WELL COMPLETION DATA:

- (1) diameter (inches) 2"
- (2) total depth (feet) 440'
- (3) static water level (feet) 40' below top of ground
- (4) casing PVC 430' (material) (depth)
- (size) if telescope see back.
- (5) screen 10' 430' (length) (depth to top)
- (size) 2" (material) PVC
- (6) pump 1/2 HP 12 gal (HP) (yield gpm)
- (type power) Ele
- (7) electric log No (yes or no)

(organization running log)

(8) how well bottom plugged 2" (back) water valve

DRILLERS REMARKS: 1983


CODED

DEPT. OF NATURAL RESOURCES
BUREAU OF LAND & WATER RESOURCES

NOV 8 1984
RECEIVED

If well telescopes please sketch and show depths.

GROUND LEVEL

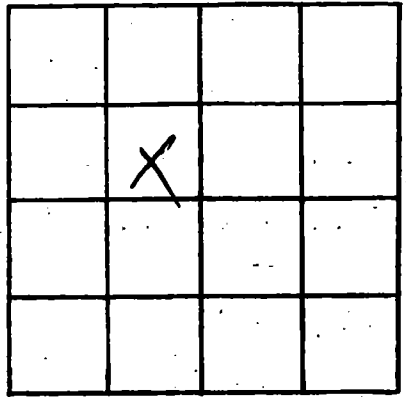

SECTION _____

Please indicate well location X.

ADDITIONAL INFORMATION

If more than one screen, show locations of each on sketch.