

MISSISSIPPI DEPARTMENT OF NATURAL RESOURCES

Bureau of Land and Water Resources

Southport Mall

P.O. Box 10631

Jackson, Mississippi 39209

WATER WELL DRILLERS LOG

CODED

J 1160
JACKSON CO.
11-14-84

11-14-84 date well completed
Coast Water Well Serv. Inc. firm name
Jackson county well located

LANDOWNER: Charles Davis
212 Cedar St.
Biloxi, Miss. 39530
(mailing address)

WELL LOCATION:
sec. 26 6 15 R. 9 E
6 miles N of OCEAN SPRINGS
(distance) (direction) (nearest town)

WELL PURPOSE: home
(home, irrigation, municipal, industrial)

WELL COMPLETION DATA:
(1) diameter (inches) 2"
(2) total depth (feet) 724'
(3) static water level (feet) 25' below top of ground
(4) casing PVC 704'
(material) (depth)
2" if telescope see back.
(size)
(5) screens 20' 704'
(length) (depth to top)
5" PVC
(size) (material)
(6) pump L.R.P. 13
(HP) (yield gpm)
Elect
(type power)
(7) electric log no
(yes or no)
(organization running log)
(8) how well bottom plugged
backwash valve


description of formations encountered	from	to
<u>Red Clay</u>	<u>0</u>	<u>20'</u>
<u>White sand</u>	<u>20'</u>	<u>35'</u>
<u>Blue Clay</u>	<u>35'</u>	<u>320'</u>
<u>fine sand</u>	<u>320'</u>	<u>330'</u>
<u>Blue Clay</u>	<u>330'</u>	<u>420'</u>
<u>fine sand</u>	<u>420'</u>	<u>435'</u>
<u>Blue Clay</u>	<u>435'</u>	<u>555'</u>
<u>Blue Clay - Shiny</u>	<u>555'</u>	<u>670'</u>
<u>fine sand</u>	<u>670'</u>	<u>690'</u>
<u>Coarse sand</u>	<u>690'</u>	<u>724'</u>
<u>5 ft. 2" tail pipe</u>		

1-8-85
JG

DRILLERS REMARKS:

If well telescopes please sketch and show depths.

GROUND LEVEL

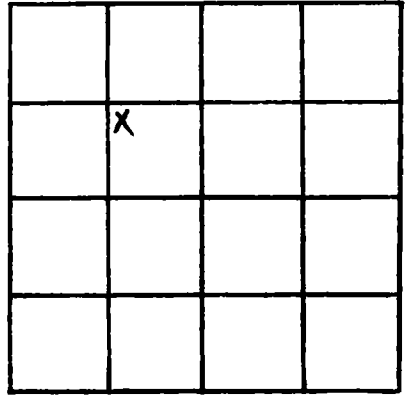

SECTION 26

Please indicate well location X.

ADDITIONAL INFORMATION

If more than one screen, show locations of each on sketch.