

# JACKSON MISSISSIPPI BOARD OF WATER COMMISSIONERS

~~N 165~~ J161

12-10-65

## WATER WELL DRILLERS LOG

Date: 12-10-65, 19  , Driller: C. T. Switzer Well @ County Jackson

55

(Name)

(1) Owner of Land: Pete Leoney  
(Name)  
East of Bilbo, Vealey Road, 1/2 mile  
S. Retimer Community Home  
(Address)

(2) Location: SE 1/4, NE 1/4, Sec. 14 T689N,  
                   miles                    of                     
(distance)                  (direction)                  (Nearest Town)

(3) Topography: X  
(Hilly)                  (Flat)                  (Level)

(4) Purpose of Well: domestic  
(Domestic Irrigation  
Municipal, Industrial, Other)

Description & Color of Materials Sand, Clay, Red Clay, Shell, etc.	Thick- ness Feet	Depth Feet
Mixed sand + clay	0	23
Clay	23	41
Sand	41	53
Clay	53	189
Sand	188	198
Clay	198	351
Sand	351	371
Sand, good	371	457
Sand, extra good	457	479
Sand	479	485
Clay	485	568
Clay + Sand shale	568	590
Clay	590	654
Clay + shale	654	675
Sandy shale	675	697
Shale	697	720
Clay + shale	720	742
Clay	742	897
Clay + Gullies earth	897	916
Clay + shale	916	938
Clay	938	980
Clay + shale	980	999
Clay	999	1012
Sand, good	1012	1071
Clay	1071	1142
Gullies earth	1142	1190
Clay + Gullies earth	1190	1212
Gullies earth	1212	1218
Sand fine	1218	1240
Rock	1240	1241
Sand fine	1241	1276
Sand, good	1276	1310

Information upon completion of well:

(1) Diameter 2 1/2 inches.

(2) Total Depth 1310' feet.

(3) Water Level 22' 6" feet below top of ground.

(4) Cased to 1310, Size 2"


(5) Screen: Size 10gn 22, Length 20'

(6) Were any formations sealed against pollution?  
X yes,            no.

If YES depth of formation                   

Why Health Dept. Requirements

Drillers Remarks:                   

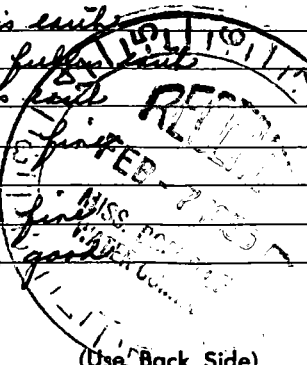

(Use Back Side)

Well No.

Faint, illegible text, possibly bleed-through from the reverse side of the page.

10/10/10

10/10/10

