

MISSISSIPPI DEPARTMENT OF NATURAL RESOURCES

Bureau of Land and Water Resources

P.O. Box 10631

Jackson, Mississippi 39209

WATER WELL DRILLERS LOG

COUNTY WELL LOCATED Jackson	
WELL NUMBER J 173	CODED
DATE WELL COMPLETED 5-25-88	

PERMIT NUMBER
NAME OF DRILLING FIRM Coast Water Well, Sew.

NAME & MAILING ADDRESS OF LANDOWNER Ray Guidry Jim Ramsay Rd Vanceville MS			
WELL LOCATION:	SEC	TOWNSHIP	RANGE
	3	6	8
		S	W
DISTANCE	DIRECTION	NEAREST TOWN	
5 1/2 Miles	W	of VANCEVILLE	
OTHER LANDMARK			
WELL PURPOSE: Home, Irrigation, Municipal, Industrial, Fish Pond, etc. home			

PUMP DATA		
PUMP TYPE (Circle One): Submersible, Turbine, Jet, Flowing Well, Other (Describe) _____		
POWER TYPE (Circle One): Electric, Tractor, Diesel, Gasoline, Butane, Other (Describe) _____		
Pump Capacity (GPM)	No. of Stages	Setting Depth
		FT.
PUMP TEST		
Well yielded _____ GPM with a drawdown of _____ ft. after _____ hours of pumping		

WELL DATA		
Well Depth 950'	Casing Diameter (In.) 2"	Casing Length (Ft.) 925'
Type of Casing PVC	Hole Depth 950'	Depth to Static Water Level 55'
TYPE OF COMPLETION: (Circle One or More): Gravel Packed, Underreamed, Telescoped, Natural Development, Open Hole, Other (Describe)		
Top of Lap Pipe or Reduction in Casing		
FEET	IF TELESCOPED OR MORE THAN ONE SCREEN: USE BACK PAGE	

LOG DATA	
TYPE OF LOG RUN (Circle One): Electric, Gamma Ray, Density, Sonic, Neutron, Other (Describe) _____	
(No Log Run)	
Name of Organization Running Log	

SCREEN DATA		
Diameter - Inches 2"	Length - Feet 15'	Slot Size - Inches .008
Screen Type PVC	Depth to Bottom - Feet 940'	

GEOLOGIC DATA (Office Use Only)			
Surface Elev.	Geologic Unit	Unit Thickness	Depth to Top
Subs. SWL	Date	Analysis	Aquifer Test


Driller's Remarks

DESCRIPTION OF FORMATIONS ENCOUNTERED	FROM	TO
Top Soil	0	2
Blue Clay	2	60
Brown Med Sand	60	170
Blue Clay	170	234
Med Gray sand	234	260
Blue Clay	260	470
Fine Gray sand	470	494
Blue Clay	494	920
Gray Coars sand	920	938
Blue Clay	938	950

FORMATIONS (Continued)		FROM	TO
RECEIVED			
NOV 17 1988			
Department of Natural Resources Bureau of Land & Water Resources			
IF MORE SPACE IS NEEDED, USE BACK			

If well telescopes please sketch and show depths.

GROUND LEVEL

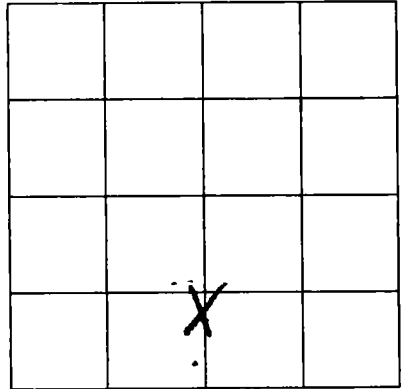

SECTION 3

Please indicate well location X.

ADDITIONAL INFORMATION

If more than one screen,
show location of each on sketch.