

**MISSISSIPPI DEPARTMENT OF ENVIRONMENTAL QUALITY**

Office of Land and Water Resources

P. O. Box 10631  
Jackson, MS 39289-0631  
**WATER WELL DRILLERS LOG**

COUNTY WELL LOCATED  
**Jackson**

WELL NUMBER  
**J 240**

CODED

DATE WELL COMPLETED  
**2-14-95**

PERMIT NUMBER

NAME OF DRILLING FIRM  
**Coast Water Well Service**

NAME & MAILING ADDRESS OF LANDOWNER  
**Chuck Koski**  
**Brad Al Rd**  
**Vandave, Ms.**

WELL LOCATION SEC TOWNSHIP RANGE  
**22 6 N 8 W**

DISTANCE DIRECTION NEAREST TOWN  
**5 1/2 Miles SW of Vandave**

OTHER LANDMARK

WELL PURPOSE  Home,  Irrigation,  Municipal,  Industrial,  Fish Pond, etc.

**PUMP DATA**

PUMP TYPE (Circle One):  
Submersible, Turbine,  **Flowing Well**,  
Other (Describe) \_\_\_\_\_

POWER TYPE (Circle One):  
 **Electric**, Tractor, Diesel, Gasoline, Butane,  
Other (Describe) \_\_\_\_\_ H/P **1**

Pump Capacity (GPM) No. of Stages Setting Depth  
**14 1** \_\_\_\_\_ FT.

PUMP TEST  
Well yielded \_\_\_\_\_ GPM with  
a drawdown of \_\_\_\_\_ ft.  
after \_\_\_\_\_ hours of pumping

**WELL DATA**

Well Depth <b>60'</b>	Casing Diameter (In.) <b>2"</b>	Casing Length (Ft.) <b>55'</b>
Type of Casing <b>PVC</b>	Hole Depth <b>60'</b>	Depth to Static Water Level <b>5'</b>

TYPE OF COMPLETION: (Circle One or More):  
 **Natural Development**,  Gravel Packed,  Underreamed,  Telescoped,  
 Open Hole,  Other

**LOG DATA**

TYPE OF LOG RUN (Circle One):  **No Log Run**,  
Electric, Gamma Ray, Density, Sonic, Neutron,  
Other (Describe) \_\_\_\_\_

Name of Organization Running Log

WELL GROUTED TO A DEPTH OF **20 FEET**  
Type Grout (circle one): Cement,  **Bentonite**, or Mix

**GEOLOGIC DATA (Office Use Only)**

Surface Elev.	Geologic Unit	Unit Thickness	Depth to Top
Subs. SWL	Date	Analysis	Aquifer Test

Driller's Remarks

Top of Lap Pipe or Reduction in Casing

FEET IF TELESCOPED OR MORE THAN ONE SCREEN: USE BACK PAGE

**SCREEN DATA**

Diameter - Inches <b>2"</b>	Length - Feet <b>5'</b>	Slot Size - Inches <b>.008"</b>
Screen Type <b>PVC</b>	Depth to Bottom - Feet <b>60'</b>	

DESCRIPTION OF FORMATIONS ENCOUNTERED	FROM	TO
<b>Top Soil</b>	<b>0</b>	<b>3</b>
<b>Grey-Pink Clay</b>	<b>3</b>	<b>20</b>
<b>White Coarse Sand</b>	<b>20</b>	<b>60</b>

FORMATIONS (Continued)

**RECEIVED**


**MAR 20 1995**

Dept. of Environmental Quality  
Office of Land & Water Resources

IF MORE SPACE IS NEEDED, USE BACK

If well telescopes please sketch and show depths.

GROUND LEVEL:

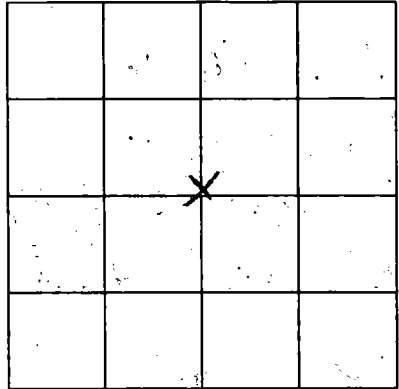

SECTION 22

Please indicate well location X.

ADDITIONAL INFORMATION

Lined area for additional information.

REGISTRATION

MAR 5 1988

Department of Environment  
Water & Power

If more than one screen,  
show location of each on sketch.