

MISSISSIPPI DEPARTMENT OF ENVIRONMENTAL QUALITY

Office of Land and Water Resources

P. O. Box 10631

Jackson, MS 39289-0631

WATER WELL DRILLERS LOG

COUNTY WELL LOCATED JACKSON	
WELL NUMBER S-2710	CODED
DATE WELL COMPLETED Sept 8 02	

PERMIT NUMBER MTM drell
NAME OF DRILLING FIRM 8877 Boss Hugley Biloxi

NAME & MAILING ADDRESS OF LANDOWNER Ivan Dixon Liz Payton Rd			
Latitude: Longitude:			
WELL LOCATION	SEC	TOWNSHIP	RANGE
	2	6^N	8^E
DISTANCE	DIRECTION	NEAREST TOWN	
5 Miles	East	of Vicksburg	
OTHER LANDMARK NONE			
WELL PURPOSE: Home, Irrigation, Municipal, Industrial, Fish Pond, etc. Home			

PUMP DATA			
PUMP TYPE (Circle One): <input checked="" type="radio"/> Submersible, <input type="radio"/> Turbine, <input type="radio"/> Jet, <input type="radio"/> Flowing Well, Other (Describe) _____			
POWER TYPE (Circle One): <input checked="" type="radio"/> Electric, <input type="radio"/> Tractor, <input type="radio"/> Diesel, <input type="radio"/> Gasoline, <input type="radio"/> Butane, Other (Describe) _____ H/P 1			

DESCRIPTION OF FORMATIONS ENCOUNTERED	FROM	TO
Top soil	1	3
orange sandy clay	3	70
gray clay	70	110
green clay	100	180
rusty sand	180	210
gr. br. clay	210	470
sand	470	540

WELL DATA		
Well Depth 540	Casing Diameter (In.) 4X2	Casing Length (Ft.) 520
Type of Casing PVC	Hole Depth 540	Depth to Static Water Level 95
TYPE OF COMPLETION: (Circle One or More): <input checked="" type="radio"/> Gravel Packed, <input type="radio"/> Underreamed, <input type="radio"/> Telescoped, <input checked="" type="radio"/> Natural Development, <input type="radio"/> Open Hole, <input type="radio"/> Other (Describe) _____		

WELL GROUTED TO A DEPTH OF 11 FEET
Type Grout (circle one): Cement, Bentonite, or Mix

SCREEN DATA		
Diameter - inches 2"	Length - Feet 20'	Slot Size - inches .006
Screen Type PVC	Depth to Bottom - Feet 540	

RECEIVED	
FEB 10 2003	
BY: OLWR	
Top of Lap Pipe or Reduction in Casing	FEET
	IF TELESCOPED OR MORE THAN ONE SCREEN: USE BACK PAGE


I certify that the well was drilled, constructed and completed in accordance with all applicable Requirements of the Mississippi Department of Environmental Quality and/or the Mississippi Department of Health regulations and state laws.

Alan Medda 0563
Signature of Licensed Driller and License No.

Feb 6, 03
Date

Additional Information Required On Back

If well telescopes please sketch and show depths.

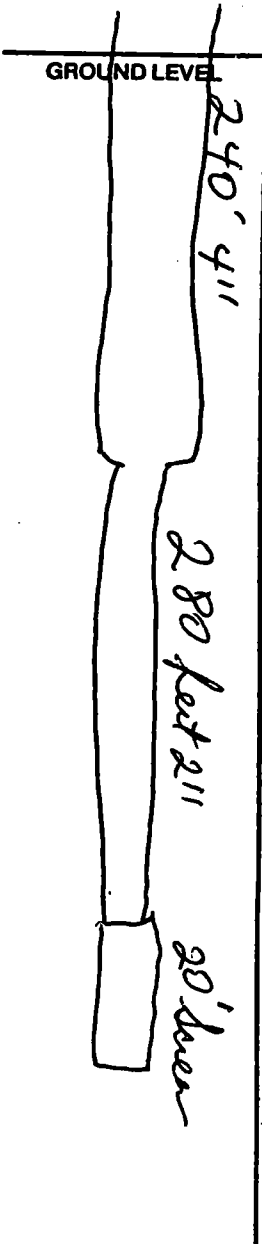

X			

SECTION 2

Please indicate well location X.

Pump Capacity (GPM) <u>15</u>	No. of Stages <u>13</u>	Setting Depth <u>120</u> 130 FT.
----------------------------------	----------------------------	---

PUMP TEST

Well yielded 25 GPM with
a drawdown of _____ ft.
after _____ hours of pumping

LOG DATA

TYPE OF LOG RUN (Circle One): No Log Run.
Electric, Gamma Ray, Density, Sonic, Neutron.
Other (Describe) _____

Name of Organization Running Log

GEOLOGIC DATA (Office Use Only)

Surface Elev.	Geologic Unit	Unit Thickness	Depth to Top
Subs. SWL	Date	Analysis	Aquifer Test

Driller's Remarks

If more than one screen,
show location of each on sketch.