

**MISSISSIPPI DEPARTMENT OF ENVIRONMENTAL QUALITY**

Office of Land and Water Resources

P. O. Box 10631  
Jackson, MS 39289-0631  
**WATER WELL DRILLERS LOG**

COUNTY WELL LOCATED <u>Spickard</u>	
WELL NUMBER <u>J-289</u>	CODED
DATE WELL COMPLETED <u>5-15-03</u>	

PERMIT NUMBER
NAME OF DRILLING FIRM <u>Coast Water Well Service</u>

NAME & MAILING ADDRESS OF LANDOWNER <u>Eugene Larson</u> <u>Arthur Ave</u>			
Latitude:			
Longitude: <u>Biloxi, Ms.</u>			
WELL LOCATION	SEC	TOWNSHIP	RANGE
	<u>35</u>	<u>6</u>	<u>9</u>
DISTANCE	DIRECTION	NEAREST TOWN	
<u>5</u> Miles	<u>NW</u>	<u>Ocean Springs</u>	
OTHER LANDMARK			
WELL PURPOSE: <input checked="" type="checkbox"/> Home, <input type="checkbox"/> Irrigation, <input type="checkbox"/> Municipal, <input type="checkbox"/> Industrial, <input type="checkbox"/> Fish Pond, etc.			

<b>PUMP DATA</b>	
PUMP TYPE (Circle One): Submersible, Turbine, <input checked="" type="radio"/> Flowing Well, Other (Describe) _____	
POWER TYPE (Circle One): <input checked="" type="radio"/> Electric, <input type="radio"/> Tractor, <input type="radio"/> Diesel, <input type="radio"/> Gasoline, <input type="radio"/> Butane, Other (Describe) _____ H/P <u>2</u>	

DESCRIPTION OF FORMATIONS ENCOUNTERED	FROM	TO
<u>Top Soil</u>	<u>0</u>	<u>2</u>
<u>Orange + Gray Clay</u>	<u>2</u>	<u>38</u>
<u>White coarse Sand</u>	<u>38</u>	<u>50</u>
<u>Blue Clay w/ Str of Sand</u>	<u>50</u>	<u>398</u>
<u>Gray Medium coarse Sand</u>	<u>398</u>	<u>419</u>

<b>WELL DATA</b>		
Well Depth <u>419'</u>	Casing Diameter (In.) <u>2"</u>	Casing Length (Ft.) <u>404'</u>
Type of Casing <u>PVC</u>	Hole Depth <u>419'</u>	Depth to Static Water Level <u>95'</u>
TYPE OF COMPLETION: (Circle One or More): <input checked="" type="checkbox"/> Gravel Packed, <input type="checkbox"/> Underreamed, <input type="checkbox"/> Telescoped, <input checked="" type="checkbox"/> Natural Development, <input type="checkbox"/> Open Hole, <input type="checkbox"/> Other (Describe): _____		
WELL GROUTED TO A DEPTH OF <u>10</u> FEET Type Grout (circle one): <input checked="" type="radio"/> Cement, <input type="radio"/> Bentonite, or <input type="radio"/> Mix		

<b>SCREEN DATA</b>		
Diameter - inches <u>20"</u>	Length - Feet <u>15'</u>	Slot Size - inches <u>006</u>
Screen Type <u>PVC</u>	Depth to Bottom - Feet <u>419'</u>	

<b>RECEIVED</b>	
JUN 04 2003	
BY: OLWR	
Top of Lap Pipe or Reduction in Casing	IF TELESCOPED OR MORE THAN ONE SCREEN: USE BACK PAGE
FEET	

I certify that the well was drilled, constructed and completed in accordance with all applicable Requirements of the Mississippi Department of Environmental Quality and/or the Mississippi Department of Health regulations and state laws.


Jack Ridgell 472  
Signature of Licensed Driller and License No.

5/31/03  
Date

Additional Information Required On Back

If well telescopes please sketch and show depths.

GROUND LEVEL

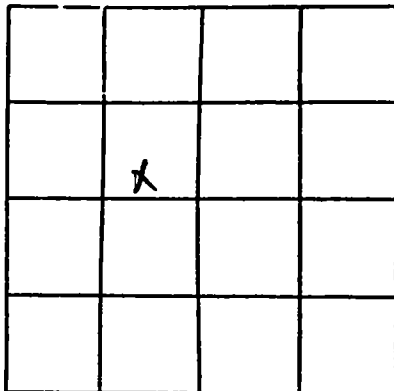

SECTION 35

Please indicate well location X.

Pump Capacity (GPM)	No. of Stages	Setting Depth	FT.
<u>8.5</u>	<u>3</u>		

PUMP TEST

Well yielded \_\_\_\_\_ GPM with  
 a drawdown of \_\_\_\_\_ ft.  
 after \_\_\_\_\_ hours of pumping

LOG DATA

TYPE OF LOG RUN (Circle One): No Log Run  
 Electric, Gamma Ray, Density, Sonic, Neutron,  
 Other (Describe) \_\_\_\_\_

Name of Organization Running Log

GEOLOGIC DATA (Office Use Only)

Surface Elev.	Geologic Unit	Unit Thickness	Depth to Top
Subs. SWL	Date	Analysis	Aquifer Test

Driller's Remarks

If more than one screen,  
 show location of each on sketch.