




If well telescopes please sketch and show depths.

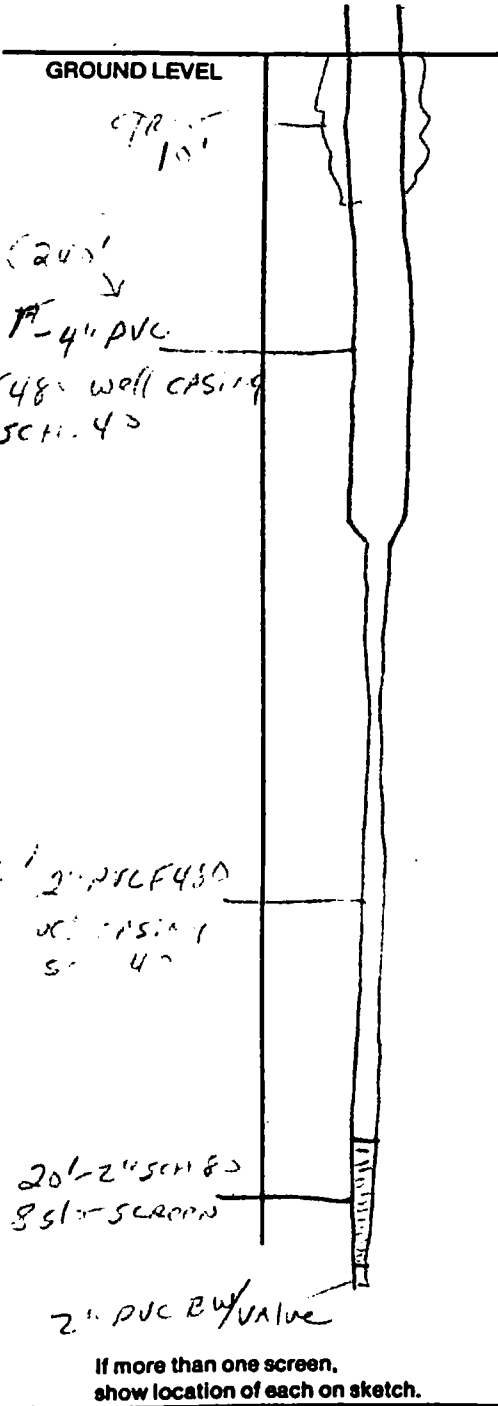

|  |  |   |  |
|--|--|---|--|
|  |  |   |  |
|  |  | X |  |
|  |  |   |  |
|  |  |   |  |

SECTION 25

Please indicate well location X.

|                     |               |               |     |
|---------------------|---------------|---------------|-----|
| Pump Capacity (GPM) | No. of Stages | Setting Depth |     |
| <u>10</u>           | <u>10</u>     | <u>140</u>    | FT. |

PUMP TEST

Well yielded \_\_\_\_\_ GPM with  
 a drawdown of \_\_\_\_\_ ft.  
 after \_\_\_\_\_ hours of pumping

LOG DATA

TYPE OF LOG RUN (Circle One): No. Log Run.  
 Electric, Gamma Ray, Density, Sonic, Neutron,  
 Other (Describe) \_\_\_\_\_

Name of Organization Running Log \_\_\_\_\_

GEOLOGIC DATA (Office Use Only)

|               |               |                |              |
|---------------|---------------|----------------|--------------|
| Surface Elev. | Geologic Unit | Unit Thickness | Depth to Top |
| Subs. SWL     | Date          | Analysis       | Aquifer Test |

Driller's Remarks

\_\_\_\_\_

\_\_\_\_\_

\_\_\_\_\_

\_\_\_\_\_

If more than one screen,  
 show location of each on sketch.