

MISSISSIPPI DEPARTMENT OF ENVIRONMENTAL QUALITY

Office of Land and Water Resources

P. O. Box 10631  
Jackson, MS 39289-0631  
WATER WELL DRILLERS LOG

COUNTY WELL LOCATED <i>Jackson</i>	
WELL NUMBER <i>J-316</i>	CODED
DATE WELL COMPLETED <i>April 16 04</i>	

PERMIT NUMBER <i>mtm well</i>
NAME OF DRILLING FIRM <i>8827 BoostHush</i>
<i>Biloxi Ms.</i>

NAME & MAILING ADDRESS OF LANDOWNER <i>Scott Shaw</i>			
<i>14613 Nature trail</i>			
<i>Ocean Springs</i>			
Latitude:			
Longitude:			
WELL LOCATION	SEC	TOWNSHIP	RANGE
	<i>3</i>	<i>60<sup>N</sup></i>	<i>8<sup>E</sup></i>
DISTANCE	DIRECTION	NEAREST TOWN	
<i>4</i>	<i>West</i>	<i>of Jordan</i>	
OTHER LANDMARK: <i>in Purg loop By Church</i>			
WELL PURPOSE: Home, Irrigation, Municipal, Industrial, Fish Pond, etc. <i>None</i>			

PUMP DATA

PUMP TYPE (Circle One):  
 Submersible, Turbine, Jet, Flowing Well,  
Other (Describe) \_\_\_\_\_

POWER TYPE (Circle One):  
 Electric, Tractor, Diesel, Gasoline, Butane,  
Other (Describe) \_\_\_\_\_ H/P *1*

DESCRIPTION OF FORMATIONS ENCOUNTERED	FROM	TO
<i>Chy</i>	<i>0</i>	<i>-15</i>
<i>Sand</i>	<i>15</i>	<i>-185</i>
<i>green chy</i>	<i>185</i>	<i>-420</i>
<i>sud</i>	<i>420</i>	<i>-487</i>

WELL DATA

Well Depth <i>487</i>	Casing Diameter (In.) <i>PVC</i>	Casing Length (Ft.) <i>487</i>
Type of Casing <i>PVC</i>	Hole Depth <i>487</i>	Depth to Static Water Level <i>85</i>
TYPE OF COMPLETION: (Circle One or More): <input checked="" type="checkbox"/> Gravel Packed, <input type="checkbox"/> Underreamed, <input type="checkbox"/> Telescoped, <input checked="" type="checkbox"/> Natural Development, <input type="checkbox"/> Open Hole, <input type="checkbox"/> Other (Describe) _____		
WELL GROUTED TO A DEPTH OF <i>14</i> FEET Type Grout (circle one): Cement, Bentonite, or Mix		

SCREEN DATA

Diameter - Inches <i>2"</i>	Length - Feet <i>15</i>	Slot Size - Inches <i>.006</i>
Screen Type <i>PVC</i>	Depth to Bottom - Feet <i>472-487</i>	

Top of Lap Pipe or Reduction in Casing

FEET  IF TELESCOPED OR MORE THAN ONE SCREEN: USE BACK PAGE

RECEIVED

APR 21 2004

BY: OLWR

I certify that the well was drilled, constructed and completed in accordance with all applicable Requirements of the Mississippi Department of Environmental Quality and/or the Mississippi Department of Health regulations and state laws.


*Al Medh 0563*  
Signature of Licensed Driller and License No.

*April 19, 04*  
Date

Additional Information Required On Back

If well telescopes please sketch and show depths.

GROUND LEVEL

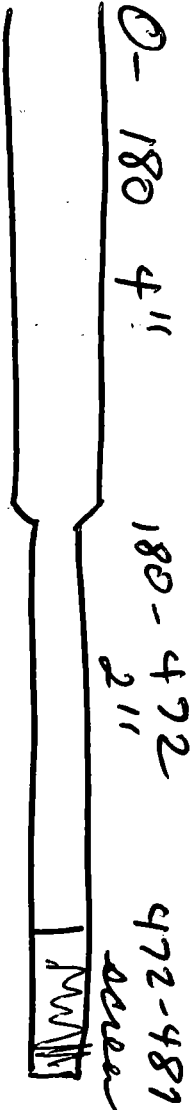

If more than one screen, show location of each on sketch.

		X	

SECTION 3

Please indicate well location X.

Pump Capacity (GPM)	No. of Stages	Setting Depth	
15	9	130	FT.

PUMP TEST

Well yielded \_\_\_\_\_ GPM with a drawdown of \_\_\_\_\_ ft. after \_\_\_\_\_ hours of pumping

LOG DATA

TYPE OF LOG RUN (Circle One):  No Log Run,  Electric,  Gamma Ray,  Density,  Sonic,  Neutron,  Other (Describe) \_\_\_\_\_

Name of Organization Running Log \_\_\_\_\_

GEOLOGIC DATA (Office Use Only)

Surface Elev.	Geologic Unit	Unit Thickness	Depth to Top
Subs. SWL	Date	Analysis	Aquifer Test

Driller's Remarks

\_\_\_\_\_  
\_\_\_\_\_  
\_\_\_\_\_  
\_\_\_\_\_