

**MISSISSIPPI DEPARTMENT OF ENVIRONMENTAL QUALITY**

Office of Land and Water Resources

P. O. Box 10631  
Jackson, MS 39289-0631

**WATER WELL DRILLERS LOG**

COUNTY WELL LOCATED <i>Franklin</i>	
WELL NUMBER <i>5-329</i>	CODED
DATE WELL COMPLETED <i>July 8, 04</i>	

PERMIT NUMBER <i>MTM well</i>
NAME OF DRILLING FIRM <i>8827 Brooks Road</i>
<i>Biloxi MS,</i>

NAME & MAILING ADDRESS OF LANDOWNER <i>Mike Dubay</i>
<i>9213 Dana St</i>
<i>Ocean Springs MS</i>
Latitude:
Longitude:

WELL LOCATION	SEC	TOWNSHIP	RANGE
	<i>35</i>	<i>6</i>	<i>9</i>

DISTANCE	DIRECTION	NEAREST TOWN
<i>1/2</i> Miles	<i>south</i>	<i>Sarou</i>

OTHER LANDMARK <i>2 1/2 miles N of H0</i>
WELL PURPOSE: Home, Irrigation, Municipal, Industrial, Fish Pond, etc. <i>Home</i>

WELL DATA		
Well Depth <i>420</i>	Casing Diameter (In.) <i>2"</i>	Casing Length (FL) <i>410</i>
Type of Casing <i>PUC</i>	Hole Depth <i>420</i>	Depth to Static Water Level <i>105</i>

TYPE OF COMPLETION: (Circle One or More): <input checked="" type="checkbox"/> Natural Development, <input type="checkbox"/> Gravel Packed, <input type="checkbox"/> Underreamed, <input type="checkbox"/> Telescoped, <input type="checkbox"/> Open Hole, <input type="checkbox"/> Other
---

WELL GROUTED TO A DEPTH OF <u><i>10</i></u> FEET Type Grout (circle one): Cement, Bentonite, or Mix
--

SCREEN DATA		
Diameter - Inches <i>2"</i>	Length - Feet <i>10</i>	Slot Size - Inches <i>1006</i>
Screen Type <i>PUC</i>	Depth to Bottom - Feet <i>10-420</i>	

PUMP DATA	
PUMP TYPE (Circle One): Submersible, Turbine, <input checked="" type="radio"/> Flowing Well, Other (Describe) _____	
POWER TYPE (Circle One): Electric, Tractor, Diesel, Gasoline, Butane, Other (Describe) _____ H/P <u><i>2</i></u>	

DESCRIPTION OF FORMATIONS ENCOUNTERED	FROM	TO
<i>top soil</i>	<i>0</i>	<i>5</i>
<i>sand</i>	<i>5-18</i>	
<i>gray clay</i>	<i>18-85</i>	
<i>open clay</i>	<i>85-365</i>	
<i>sand</i>	<i>365-420</i>	

<b>RECEIVED</b>
AUG 06 2004
<b>BY: OLWR</b>
Top of Lap Pipe or Reduction in Casing
FEET <input type="checkbox"/> IF TELESCOPED OR MORE THAN ONE SCREEN: USE BACK PAGE

I certify that the well was drilled, constructed and completed in accordance with all applicable Requirements of the Mississippi Department of Environmental Quality and/or the Mississippi Department of Health regulations and state laws.


*Al M... 0563*  
Signature of Licensed Driller and License No.

*Aug 30 04*  
Date

Additional Information Required On Back

If well telescopes please sketch and show depths.

GROUND LEVEL

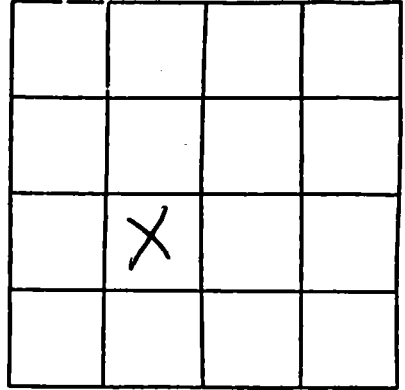

SECTION 35

Please indicate well location X.

Pump Capacity (GPM)	No. of Stages	Setting Depth
8	3	130 FT.

PUMP TEST

Well yielded \_\_\_\_\_ GPM with  
a drawdown of \_\_\_\_\_ ft.  
after \_\_\_\_\_ hours of pumping

LOG DATA

TYPE OF LOG RUN (Circle One): No Log Run,  
Electric, Gamma Ray, Density, Sonic, Neutron,  
Other (Describe) \_\_\_\_\_

Name of Organization Running Log

GEOLOGIC DATA (Office Use Only)

Surface Elev.	Geologic Unit	Unit Thickness	Depth to Top
Subs. SWL	Date	Analysis	Aquifer Test

Driller's Remarks

If more than one screen,  
show location of each on sketch.