County: JUCKSON Permit #: Mississippi Departme Office of Land P.O. Jackson, Date drilling completed: 8-24-05 (601)	Vell Report Part 1 nt of Environmental Quality and Water Resources Box 10631 MS 39289-0631 .)961-5210 54-6938 (fax) For Office Use Only: Aquifer: Well #: <u>J 369</u> L. S. Elevation: E-log #:	
30 days of completion of drilling of the well.	e driller in detail and filed with the Department within Well Location	
Well Owner Information		
Owner Name LUTZ HOMES	Latitude: <u>30 · 33 /54</u> " Longitude: <u>088 · 46 · <u>751</u>" 46 / 57 Method of Lat/Long (circle one): Conventional Survey, 57</u>	
Mailing Address: RAMSey OAKS LOT 57		
	USGS quad, Hand-held GPS, Survey-grade GPS	
Vancleave Ms 39565 City State Zip Code	$\frac{5E}{5W} \times \frac{N}{5W} \times \frac{3}{5W} \times \frac{3}{5W} \times \frac{3}{5W}$ Distance Direction Nearest Town	
Telephone No. (228) 217 - 7749	<u>5</u> Miles <u>West</u> of <u>Uan clappin</u>	
Wei	Data	
Purpose of Well (circle one) Home Industrial Public Supply		
Date well drilling started: 8-24-05 Date	well drilling completed: 8-24-05	
If flowing, method of flow regulation: Valve <u>NA</u> Other	1	
Static Water Level:feet above or below (circle one	land surface Date measured: 8-24-05	
Method of Measurement (circle one) steel tape electric tap	e air line other: REO	
Static Water Level:		
Type of grout (circle one): Cement Bentonite Mix	Die 30 2005	
Casing length: 152 feet Casing diameter:	inches Type of casing: <u>PVC</u> BY: OLWR	
Screen length: <u>15</u> feet Screen diameter: <u>2</u> inches Type of screen: <u>PVC</u>		
Screen slot size: . OO& inches Setting depth: From	152 feet to 167 feet	
Type of completion (circle all applicable): Gravel packed Und	erreamed Telescoped Open hole Natural Development	
Other (describe):		
Top of lap pipe or reduction in casing: <u>NA</u> feet. If t	elescoped or more than one screen, describe on back of page	
Logs run (circle all applicable): No log run Electric Gamma Ra	y Density Sonic Neutron Other:	
Name of organization running log(s): NA		
	accordance with all applicable requirements of the Mississippi	
Department of Environmental Quality and/or the Mississippi Department of Health regulations and state laws.		
Jack Kidgdell 0-472 Jack / Kat Jack		
Print Name of Water Well Contractor and License No.	Signature of Water Well Contractor	

•


If well telescopes please sketch below and show depths.

G

. .

Ground Level	Description of Formations Encountered	From To
	Top Soil Orange Clay Blue Clay Orange Clay White Course Sand	0 / 19 37 37/23 123 167
	White Coarse Sand	

If more than one screen, show location of each on sketch

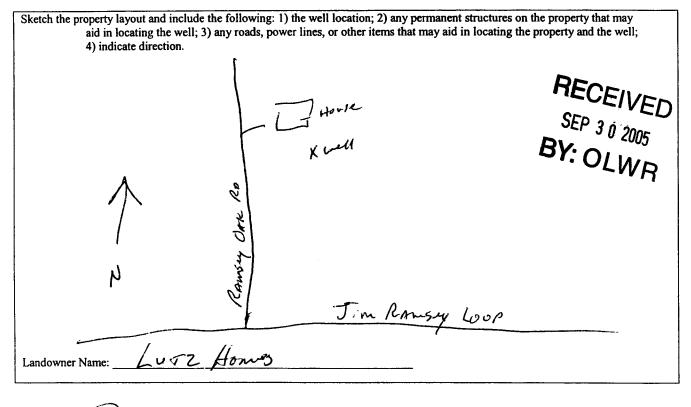

Signature of Water Well Contractor