State Well Report					
County: JACKSON	Р	art 1	For Office Use Only:		
		t of Environmental Quality	Aquifer:		
Permit #:		nd Water Resources Box 10631	Well #: <u>J-327</u>		
Driller: CO25+ Water Wellsky,	Jackson, M	IS 39289-0631	L. S. Elevation:		
Date drilling completed: <u>9-17-05</u>	• •	961-5210 4 6038 (fax)	E-log #:		
	(001)55	4-6938 (fax)	L-log #		
State Law requires that this report be prepared by the driller in detail and filed with the Department within 30 days of completion of drilling of the well.					
Well Owner Information		Well Location			
Owner Name Ray Premeaux		Latitude: <u>30 • 31 ' 164'</u> " Longitude <u>68 • 46 ' 227</u> "			
Mailing Address: 12942 Ridgeland		Method of Lat/Long (circle one): Conventional Survey,			
		USGS quad, Hand-held GPS, Survey-grade GPS			
Vancleave, MS 39565 City State Zip Code		NE 1/4 NE 1/4 Sec 15 Twn T65 Rng RBW			
City State Zip Code Telephone No. 228 326 - 2774		Distance Direction 4/2-Miles	Nearest Town		
Telephone No. 919 000 01			or have and		
	Well 1				
Purpose of Well (circle one) (Home) Inde		·	Other:		
Date well drilling started: <u>9-16-05</u> Date well drilling completed: <u>9-17-05</u>					
If flowing, method of flow regulation: Val	ve <u>NA</u> Other (d	escribe)			
Static Water Level:					
Method of Measurement (circle one) steel tape electric tape air line other:					
Hole depth: 525' Well depth: 525' Well grouted to a depth of 10 feet					
Type of grout (circle one): Cement Bentonite Mix					
Casing length: <u>5/5</u> feet Casing diameter: <u>2</u> inches Type of casing: <u>PVC</u>					
Screen length: <u>10</u> feet Screen diameter: <u>2</u> inches Type of screen: <u>PVC</u>					
Screen slot size:					
Type of completion (circle all applicable): Gravel packed Underreamed Telescoped Open hole Natural Development					
Other (describe):					
Top of lap pipe or reduction in casing:feet. If telescoped or more than one screen, describe on back of page					
Logs run (circle all applicable) No log run Electric Gamma Ray Density Sonic Neutron Other:					
Name of organization running log(s): N/A I certify that the well was drilled, constructed, and completed in accordance with all applicable requirements of the Mississippi					
Department of Environmental Quality and/or the Mississippi Department of Health regulations and state laws.					
Jack Ridgdell O-	472	Jail	Relphill,		
Print Name of Water Well Contractor and I	License No.	Signature of	Water Well Contractor		

• • • • •

-----

orn zwents BY: CarlwR

ブ-31つ


If well telescopes please sketch below and show depths.

Ground Level

¢

	Description of Formations Encountered TOPSOIL White & Gray Clay Brown Coarse Sand Blue Clay White Coarse Sand Blue Clay WStreams of SAND Gray Coarse Sand	From 9 9 17 17 100 13 13 494	To 770 770 770 770 770 770 770 770 770 77

If more than one screen, show location of each on sketch

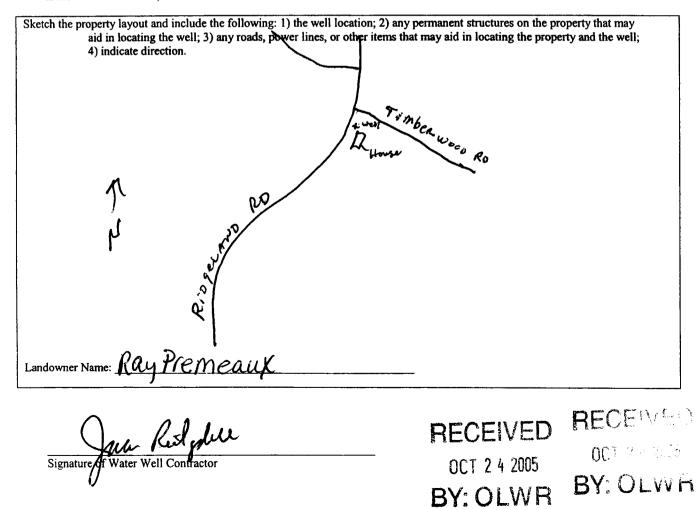

STATE WELL REPORT					
County: DICK SON   Pump Installer     Permit #:	For Office Use Only:   s Completion Report   nt of Environmental Quality   and Water Resources   Box 10631   MS 39289-0631   9961-5210   54-6938 (fax)				
This report should be prepared by the pump installer in detail and filed with the Department within 30 days of the installation of pump.					
Well Owner Information	Well Location				
Owner Name: Ray Premeaux	Latitude: 30°31'764" Longitude: 088 46 327"				
Mailing Address: 12942 Ridgeland	Method of Lat/Long (circle one): Conventional Survey,				
<b>.</b>	USGS quad, Hand-held GPS, Survey-grade GPS				
Vancleave MS 39565 City State Zip Code	NE 1/ NE 1/4 Sec 15 Twn T65 Rng R8W				
City State Zip Code	Distance Direction Nearest Town				
Telephone No. (208326 - 2774	4/2 Miles West of VANeberry				
Pump Type	Power Type				
Circle one	Circle one				
Air Lift Jet Submersible	Diesel Engine Gasoline Engine Natural Gas				
Bucket Piston Turbine	Electric Motor Hand Tractor PTO				
Centrifugal Rotary Flowing Well	Windmill Other (specify):				
Other (specify):	Horse Power Rating of Motor:				
Date Pump Installed: 9-21-05	Setting Depth: 120 FT Drop pipeteet				
Rated Pump Capacity:6Gallons Per Minute	Number of Stages:				
Pump Test Data	Method of Measuring Water Level				
Date Well Tested: <u>9-21-05</u>	Circle one				
Static Water Level (A): <u>90</u> Feet Below Land Surface	Air Line Electric Measuring Line Steel Tape				
Pumping Water Level (B): <u>N/A</u> Feet Below Land Surface	Other (specify):				
Drawdown [(B) – (A)]: $N/A$ Feet Below Land Surface	For flowing well, measured shut in head:				
Test Pumping Rate: Gallons Per Minute	Well yielded GPM with a drawdown of				
Duration of Pump Test (minimum 4 hours):4 hours	N/H feet after $N/A$ hours of pumping				
I HEREBY CERTIFY that the above statements are true to the best of <u>JOSHUA Ridgdell 0-715P</u> Print Name of Pump Installer and License No. (if applicable)	Signature of Pump Installer RECEIVED				
	OCT 2 4 2005				
	BY: OLWR				

: •