State Well Report		
County: Uackson Part 1 Nississimpi Department of Environmental Ou	For Office Use Only:	
	ality Aquifer:	
Permit #: Office of Land and Water Resources P.O. Box 10631	Well #: <u>J-413</u>	
Driller: COCK+ WCITCI WCIISIV Jackson, MS 39289-0631	L. S. Elevation:	
Date drilling completed: 3-29-00 (601)961-5210 (601)354-6938 (fax)	E-log #:	
State Law requires that this report be prepared by the driller in detail and filed with the Department within		
30 days of completion of drilling of the well. Well Owner Information	Well Location	
	311 " Longitude 088° 46, 591,	
	ircle one): Conventional Survey, 34	
	\sim	
	id-held GPS, Survey-grade GPS	
	3 Jun Tes Rng R8W	
Distance Direct	of Variation	
Telephone No. (288) . 975 - 101058	of Vand Law	
Well Data		
Purpose of Well (circle one) Home Industrial Public Supply Irrigation Fish Cult		
Date well drilling started: 3-29-00 Date well drilling completed: 3-29-00		
If flowing, method of flow regulation: Valve NA Other (describe)		
Static Water Level: 25'feet above of below (circle one) land surface Date measured: 3-29-00		
Method of Measurement (circle one) steel tape electric tape air line other:		
Hole depth: <u>147</u> Well depth: <u>147</u> Well grouted to a depth of <u>10</u> feet		
Type of grout (circle one): Cement Bentonite Mix		
Casing length: 137 feet Casing diameter: 2 inches Type of casing: DVC		
Screen length: 10 feet Screen diameter: 2 inches Type of screen: PVC		
Screen slot size: • 008 inches Setting depth: From 37 feet to 47 feet		
Type of completion (circle all applicable): Gravel packed Underreamed Telescoped Open hole Natural Development		
Other (describe):		
Top of lap pipe or reduction in casing:feet. If telescoped or more than one screen, describe on back of page		
Logs run (circle all applicable). No log run Electric Gamma Ray Density Sonic Neu	tron Other:	
Name of organization running log(s): NIA I certify that the well was drilled, constructed, and completed in accordance with all applicable requirements of the Mississippi		
Department of Environmental Quality and/or the Mississippi Department of Health regulations and state laws.		
JUCK Klagdell U-412	he forten and	
Print Name of Water Well Contractor and License No.	ature of Water Well Contractor	
	RECEIVEL	

₽V.

MAY 0 3 2006 BY: OLWR If well telescopes please sketch below and show depths.


J-413

Ground Level

,*

Description of Formations Encountered TOP SOIL Orange Clay Brown Coarse Sand Orange Clay Brown Warse Sand	From To Q 21 Q 20 Q 20 Q 20 Q 20 Q 20 Q 20 Q 20 Q 20

If more than one screen, show location of each on sketch

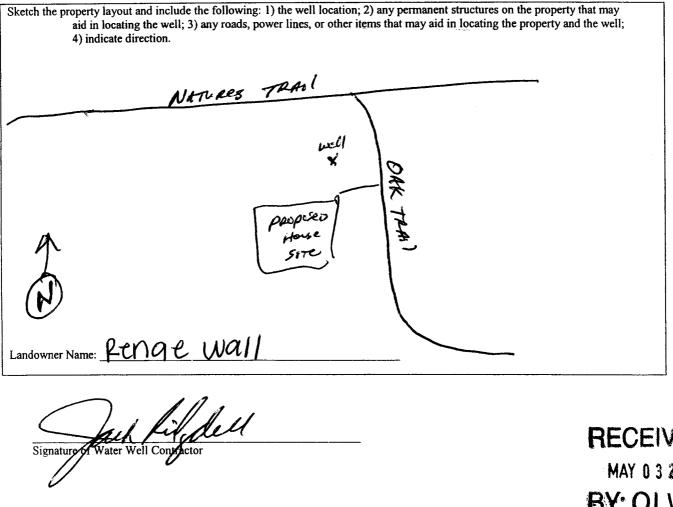

RECEIVED MAY 0 3 2006 **BY: OLWR**

STATE WELL REPORT		
County: Jackson Pump Installe Permit #:	Part 2 For Office Use Only: err's Completion Report Aquifer: hent of Environmental Quality Aquifer: 0. Box 10631 Well #: <u>J 413</u> MS 39289-0631 Elevation:	
This report should be prepared by the pump installer in de	etail and filed with the Department within 30 days of the	
installation of pump. Well Owner Information	Well Location	
Owner Name: RENAE Wall	Latitude: <u>30 33 379 "</u> Longitude: <u>088 46 596</u> "	
Mailing Address: 9910 Oak Trail (Lot 49)	Method of Lat/Long (circle one): Conventional Survey,	
	USGS quad, Hand-held GPS, Survey-grade GPS	
Vandeave MS 39565	NW1/ NE 1/2 Sec 3_Twn TUS Rng R 800	
	Distance Direction Nearest Town	
Telephone No. (228) 875 - 101058	5_Miles NW of Vancieave	
Pump Type	Power Type	
Circle one	Circle one	
Air Lift Jef Submersible	Diesel Engine Gasoline Engine Natural Gas	
Bucket Piston Turbine	Electric Motor Hand Tractor PTO	
Centrifugal Rotary Flowing Well	Windmill Other (specify):	
Other (specify):	Horse Power Rating of Motor:	
Date Pump Installed: <u>U-8-0U</u>	Setting Depth: 40 FT Drop Pipereet	
Rated Pump Capacity: Gallons Per Minute	Number of Stages:	
Pump Test Data	Method of Measuring Water Level	
Date Well Tested: <u>U-8-00</u>	Circle one	
Static Water Level (A):Feet Below Land Surface	Air Line Electric Measuring Line Steel Tape	
Pumping Water Level (B): NIA_Feet Below Land Surface	Other (specify):	
Drawdown [(B) - (A)]: NA Feet Below Land Surface	For flowing well, measured shut in head: <u>NIA</u> feet	
Test Pumping Rate: Gallons Per Minute	Well yielded GPM with a drawdown of	
Duration of Pump Test (minimum 4 hours):hours	N/A feet after N/A hours of pumping	
I HEREBY CERTIFY that the above statements are true to the bes BEN RIDOCH 0-713/ Print Name of Pump Installer and License No. (if applicable)	st of my knowledge. Bun Ridgdull Signature of Pump Installer	
רושו ואמווי טו רשוויף האמוריו מוט בוכרואב זאט. (וו מטחולמטוב)	RECEIVED	
	JUL 07 2006	
	BY: OLWR	

, , E,