Stata W	ell Report					
	art 1	For Office Use Only:				
	of Environmental Quality	Aquifer:				
Permit #: Office of Land as	nd Water Resources	Weil #: J- 416				
	P.O. Box 10631 Jackson, MS 39289-0631					
1	961-5210	L. S. Elevation:				
(601)354	I-6938 (fax)	E-log #:				
State Law requires that this report be prepared by the driller in detail and filed with the Department within 30 days of completion of drilling of the well.						
Well Owner Information	Wel	Location				
Owner Name <u>Landy</u> Wrigiey	· · · · · · · · · · · · · · · · · · ·	0' Longitude: 088° 49, 517				
Mailing Address: Jord An Rd.	Method of Lat/Long (circle or	e): Conventional Survey,				
	USGS quad, Hand-held	GPS, Survey-grade GPS				
Ocean Springs MS 39565 City State Zip Code	NE1/4 NW1/4 Sec. 30	Twn TGS Rng R8W				
Telephone No. 208334-4453	Distance Direction Miles North	Nearest Town of Ocean Springs				
Well I	)ata					
		Other				
	-					
Date well drilling started: <u>4-20-01</u> Date w	vell drilling completed:	dU = UU				
If flowing, method of flow regulation: Valve NIA Other (d	escribe)					
Static Water Level: <u>25</u> feet above or below circle one) land surface Date measured: <u>4-20-00</u>						
Method of Measurement (circle one) steel tape electric tape air line other:						
Hole depth: <u>33</u> Well depth: <u>33</u> Well grouted to a depth of <u>6</u> feet						
Type of grout (circle one): Cement Bentonite Mix						
Casing length: 222 feet Casing diameter: inches Type of casing:						
Screen length:feet Screen diameter:inches Type of screen: Screen slot size:, OO(0 inches Setting depth: Fromfeet tofeet to						
Type of completion (circle all applicable): Gravel packed Underreamed Telescoped Open hole (Natural Development) Other (describe):						
Top of lap pipe or reduction in casing:feet. If telescoped or more than one screen, describe on back of page						
Logs run (circle all applicable) No log run Electric Gamma Ray Density Sonic Neutron Other:						
Name of organization running log(s): NH I certify that the well was drilled, constructed, and completed in accordance with all applicable requirements of the Mississippi						
Department of Environmental Quality and/or the Mississippi Dep		1				
Jack Ridadell D-472		h Käsghell				
Print Name of Water Well Contractor and License No.	Signature of	Water Well Contractor				
hanner,		RECEIVED				
		MAY 17 2006				

• • •

> MAY 17 2006 BY: OLWR

.


## J- 416

If well telescopes please sketch below and show depths.

Ground Level

 Description of Formations Encountered TOP SOIL OFANGE CLAY W/ Streats OF SE BILLE CLAY AVAY COALSE SAND	$\mathcal{O}$	

If more than one screen, show location of each on sketch

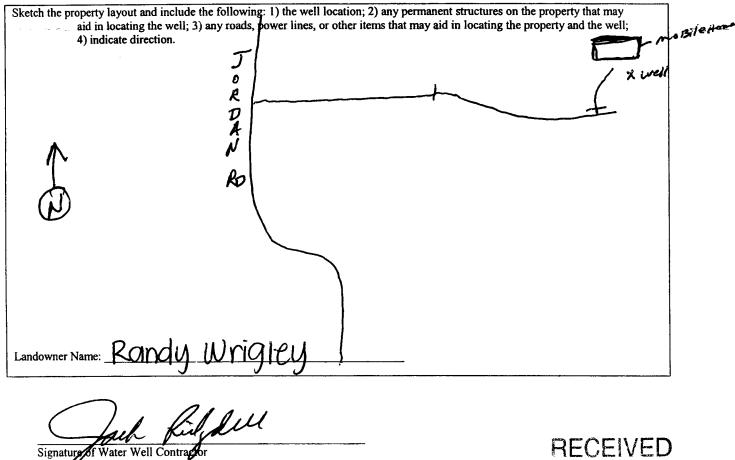

Signature of Water Well Contractor

MAY 17 2006 **BY: OLWR** 

	STATE WE	LL REPORT	ſ	
County: JACKSON Permit #: Driller: COASE WATER WELSE Date completed: - AO - OG	Part 2 Pump Installer's Completion Report Mississippi Department of Environmental Quality Office of Land and Water Resources P.O. Box 10631 Jackson, MS 39289-0631 (601)961-5210 (601)354-6938 (fax)		aality Aquifer:  Well #: Elevation:	fice Use Only:
This report should be prepared by the installation of pump.	e pump installer in deta	il and filed with the l		ays of the
Well Owner Informat Owner Name: Randy Wrio Mailing Address: Jondan Ra Octan Springs A City State Telephone No. (2018) 32.4.44	1ey 5 <u>395</u> 65 <sub>Zip Code</sub>	Method of Lat/Long USGS qu <u>NE</u> ¼ <u>NW</u> ¼ Distance Di	Well Location (circle one): Convention ad, Hand-held GPS, Sur Sec 80 Twn TWS irection Nearest To 10 Mb of OCCA (S	nal Survey, rvey-grade GPS Rng <b>£8</b> W
Pump Type			Power Type	<u> </u>
Circle one			Circle one	
Air Lift Jet	Submersible	Diesel Engine	Gasoline Engine	Natural Gas
Bucket Piston	Turbine	Electric Motor	Hand	Tractor PTO
Centrifugal Rotary Other (specify): Date Pump Installed:Q Rated Pump Capacity:		Windmill Horse Power Rating Setting Depth: 40 Number of Stages: _	<b>•</b> •	feet
Pump Test Data Date Well Tested: 5 - 20 - C	00	Meth	od of Measuring Water Circle one	· Level
Æ	Below Land Surface	Air Line Ele	ectric Measuring Line	RECEIVED
Pumping Water Level (B): NAFeet	Below Land Surface	Other (specify):		JUN 1 5 2006
Drawdown [(B) - (A)]:Feet	Below Land Surface	For flowing well, m	easured shut in head:	WWW OLWR
Test Pumping Rate: Duration of Pump Test (minimum 4 hours)	Gallons Per Minute	Well yieldedf	A 112	drawdown of nours of pumping
I HEREBY CERTIFY that the above statements are true to the best of my knowledge. JACK R.O. GACII 0-472 Print Name of Pump Installer and License No. (if applicable) Signature of Pump Installer				

.'

•