State W	ell Report						
County: Jackson Pa	art 1	For Office Use Only:					
Mississippi Department	of Environmental Quality	Aquifer:					
	nd Water Resources	well #: J- 427					
	ox 10631						
Jackson, IVA	S 39289-0631 061-5210	L. S. Elevation:					
Date drives	-6938 (fax)	E-log #:					
State Law requires that this report be prepared by the driller in detail and filed with the Department within							
30 days of completion of drilling of the well. Well Owner Information	Well	Location					
Owner Name_Bill Cooley	Latitude: 30.30,947	1" Longitude 88.46, 197"					
Mailing Address: Seaman Rd	Method of Lat/Long (circle on	e): Conventional Survey,					
	USGS quad, Hand-held	I GPS, Survey-grade GPS					
Vancleave MS 39565 City State Zip Code	N 1/4 NE 1/4 Sec 22	Twn T65 RngR8W					
Telephone No. $\partial \partial 8 \partial 6 - i546$	Distance Direction $\mathcal{L}$ Miles $\mathcal{L}$	Nearest Town of VAnclean					
Well D	lata						
Purpose of Well (circle one) Home Industrial Public Supply Irrigation Fish Culture Other:							
Date well drilling started: <u>7-25-06</u> Date w							
If flowing, method of flow regulation: Valve Other (describe)							
Static Water Level:feet above or below circle one) la							
Method of Measurement (circle one) steel tape electric tape air line other:							
Hole depth: <u>478</u> Well depth: <u>478</u> Well grouted to a depth of <u>10</u> feet							
Type of grout (circle one): Cement Bentonite Mix		0.1-					
Casing length: <u>463</u> feet Casing diameter: <u>2</u>							
Screen length: feet Screen diameter:	inches Type of screen:	<u>pvc</u>					
Screen slot size: <u>6004</u> inches Setting depth: From <u>463</u> feet to <u>478</u> feet							
Type of completion (circle all applicable): Gravel packed Underreamed Telescoped Open hole Natural Development							
Other (describe):							
Top of lap pipe or reduction in casing: N/A feet. If telescoped or more than one screen, describe on back of page							
Logs run (circle all applicable): No log run Electric Gamma Ray Density Sonic Neutron Other:							
Name of organization running log(s): NA I certify that the well was drilled, constructed, and completed in accordance with all applicable requirements of the Mississippi							
I certify that the well was drilled, constructed, and completed in accordance with all applicable requirements of the Mississippi Department of Environmental Quality and/or the Mississippi Department of Health regulations and state laws.							
Jack Ridadel 10-472	In da	Reliden					
Print Name of Water Well Contractor and License No.	Signature of	f Water Well Contractor					
	V	BFCEIVED					

÷.

7

AUG 1 5 2006 BY: OLWR

J-427


If well telescopes please sketch below and show depths.

Ground Level

1

 Description of Formations Encountered TOP SOLL Orange Mick Clay Wistreaksof Strip Grown Coarse sand Bluechay	From	
Bitle Clay wistreaks Of sard Ow med. to med. Gray Sand	201 221 451e	

If more than one screen, show location of each on sketch

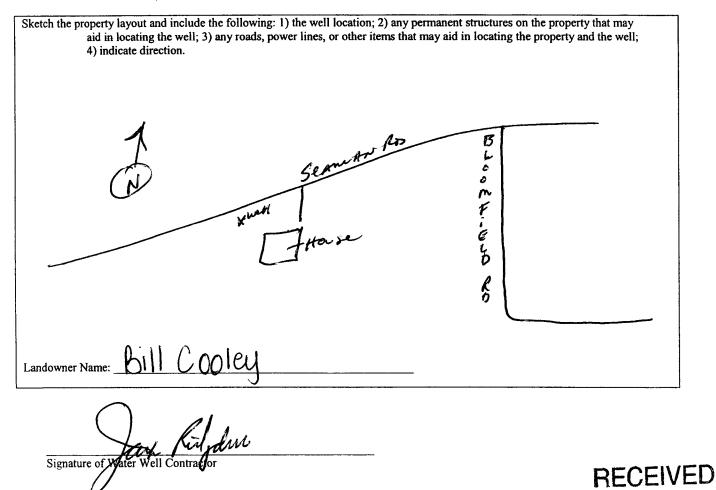

AUG 1 5 2006 BY: OLWR

	STATE WI	ELL REPOR	T	
County: Jackson Permit #: DrillerCoast Water Well SAV. Date completed: _7-27-010	Pump Installer Mississippi Departmen Office of Land P.O. Jackson, M (601	Part 2 s Completion Report to of Environmental ( and Water Resources Box 10631 MS 39289-0631 )961-5210 64-6938 (fax)	rt Quality Aquife ———— Well #	For Office Use Only: 
This report should be prepared by th	e pump installer in det	ul and filed with the	Department within	a 30 days of the
installation of pump. Well Owner Informat Owner Name: BILL COOLEY Mailing Address: Seama Vancleave, MS City State Telephone No. 628, 8210 - 154	<u>n Rd.</u> 39565 Zip Code	Method of Lat/Lor USGS $\mathcal{N}_{1/4} \mathcal{N} \mathcal{E}_{1/4}$ Distance	ng (circle one): Conv quad Hand-held GP 4 Sec 22 Twn	de: <u>088 46 19</u> 7" rentional Survey, S. Survey-grade GPS <u>T65</u> Rng <u>R 866</u> rest Town
Pump Type Circle one			Power Type Circle one	2
Air Lift Jet	Submersible	Diesel Engine	Gasoline Engine	Natural Gas
Bucket Piston	Turbine	Electric Motor	Hand	Tractor PTO
Centrifugal Rotary	Flowing Well	Windmill	Other (specify):	
Other (specify): Date Pump Installed:7 - 28 - Rated Pump Capacity:6	Gallons Per Minute	1	)OFT Drop	
Pump Test Data   Date Well Tested: 7 -0   Static Water Level (A): 80 Feet   Pumping Water Level (B): N A Feet   Drawdown [(B) – (A)]: N A Feet		Air Line E Other (specify):	thod of Measuring Circle one Electric Measuring Li measured shut in hea	ne Steel Tape
Test Pumping Rate:6	Gallons Per Minute	Well yielded	6 GPM	
I HEREBY CERTIFY that the above statem <u>JCM</u> EIKINS 0- Print Name of Pump Installer and License N	716P		of Fump Installer	RECEIVED
				AUG 1 5 2006
				BY: OLWR

<u>'</u>