

State Well Report

Part 1

Mississippi Department of Environmental Quality
Office of Land and Water Resources
P.O. Box 10631
Jackson, MS 39289-0631
(601)961-5210
(601)354-6938 (fax)

For Office Use Only:

Aquifer: _____
Well #: J-463
L. S. Elevation: _____
E-log #: _____

County: Jackson
Permit #: _____
Driller: Coast Water Wells, S.V.
Date drilling completed: 7-12-07

State Law requires that this report be prepared by the driller in detail and filed with the Department within 30 days of completion of drilling of the well.

Well Owner Information	Well Location
Owner Name: <u>Louis Richards</u>	Latitude: <u>30° 31' 78"</u> Longitude: <u>088° 44' 55.6"</u>
Mailing Address: <u>Morninglory Rd.</u>	Method of Lat/Long (circle one): Conventional Survey, <u>42</u> <u>33</u>
<u>Vancleave MS 39565</u>	USGS quad, <u>(hand-held GPS)</u> Survey-grade GPS
City State Zip Code	<u>NE 1/4 NW 1/4 Sec 13</u> Twn <u>T6S</u> Rng <u>R8W</u>
Telephone No. <u>601-218-4356</u>	Distance Direction Nearest Town <u>3</u> Miles <u>West</u> of <u>Vancleave</u>

Well Data

Purpose of Well (circle one) Home Industrial Public Supply Irrigation Fish Culture Other: _____

Date well drilling started: 7-9-07 Date well drilling completed: 7-12-07

If flowing, method of flow regulation: Valve N/A Other (describe) _____

Static Water Level: 95 feet above or (below) (circle one) land surface Date measured: 7-12-07

Method of Measurement (circle one) steel tape electric tape (air line) other: _____

Hole depth: 480 FT Well depth: 480 FT Well grouted to a depth of 10 feet

Type of grout (circle one): Cement (Bentonite) Mix

Casing length: 260' x 4" feet Casing diameter: 4 X 2 inches Type of casing: PVC

Screen length: 30 feet Screen diameter: 2 inches Type of screen: PVC

Screen slot size: .008 inches Setting depth: From 450 feet to 480 feet

Type of completion (circle all applicable): Gravel packed Underreamed Telescoped Open hole (Natural Development)

Other (describe): _____

Top of lap pipe or reduction in casing: N/A feet. If telescoped or more than one screen, describe on back of page

Logs run (circle all applicable): (No log run) Electric Gamma Ray Density Sonic Neutron Other: _____

Name of organization running log(s): N/A

I certify that the well was drilled, constructed, and completed in accordance with all applicable requirements of the Mississippi Department of Environmental Quality and/or the Mississippi Department of Health regulations and state laws.


Jack Ridgell 0-472

Print Name of Water Well Contractor and License No.

Jack Ridgell
Signature of Water Well Contractor

J-463


If well telescopes please sketch below and show depths.

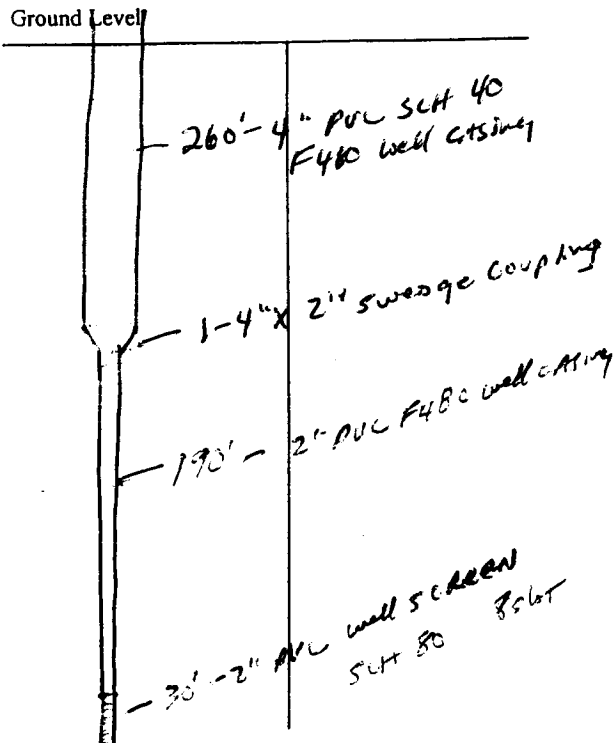

Description of Formations Encountered	From	To
Top Soil	0	2
Orange Clay	2	30
Brown Coarse Sand	30	68
Orange Clay	68	105
Brown Coarse Sand	105	150
Blue Clay w/ streaks of Sand	150	436
Gray coarse Sand	436	480

If more than one screen, show location of each on sketch

Sketch the property layout and include the following: 1) the well location; 2) any permanent structures on the property that may aid in locating the well; 3) any roads, power lines, or other items that may aid in locating the property and the well; 4) indicate direction.

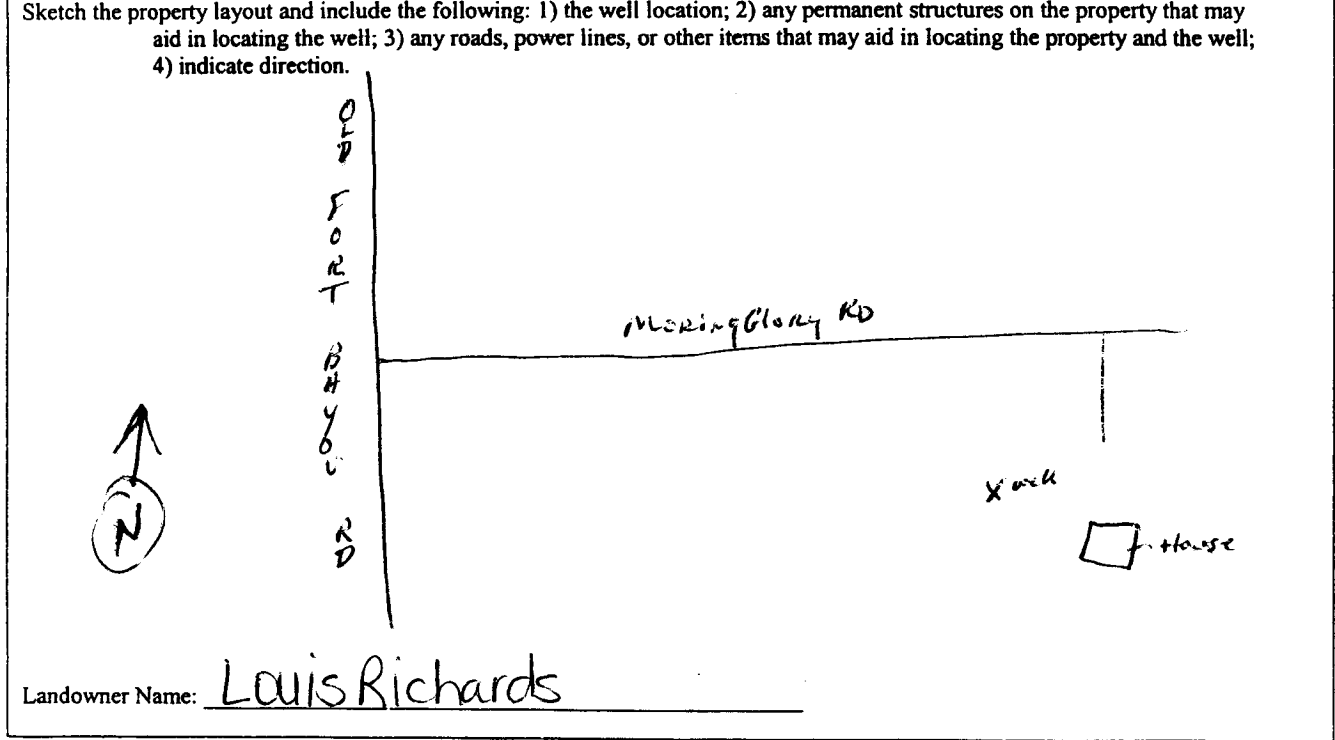

Signature of Water Well Contractor

STATE WELL REPORT

Part 2

Pump Installer's Completion Report
 Mississippi Department of Environmental Quality
 Office of Land and Water Resources
 P.O. Box 10631
 Jackson, MS 39289-0631
 (601)961-5210
 (601)354-6938 (fax)

For Office Use Only:

Aquifer: _____

Well #: J-463

Elevation: _____

County: Jackson
 Permit #: _____
 Driller: Coast Water Well Serv.
 Date completed: 7-12-07

This report should be prepared by the pump installer in detail and filed with the Department within 30 days of the installation of pump.

Well Owner Information	Well Location
Owner Name: <u>Louis Richards</u>	Latitude: <u>30° 31' 78.4"</u> Longitude: <u>088° 44' 55.6"</u>
Mailing Address: <u>Morninglory Rd</u>	Method of Lat/Long (circle one): Conventional Survey,
<u>Vanceleave MS 391565</u>	USGS quad, <u>(Hand-held GPS)</u> Survey-grade GPS
City State Zip Code	<u>NE</u> 1/4 <u>NW</u> 1/4 Sec <u>13</u> Twn <u>T6S</u> Rng <u>R8W</u>
Telephone No. <u>228) 218-4356</u>	Distance Direction Nearest Town
	<u>3</u> Miles <u>West</u> of <u>Vanceleave</u>

Pump Type Circle one	Power Type Circle one
Air Lift Jet <u>Submersible</u>	Diesel Engine Gasoline Engine Natural Gas
Bucket Piston Turbine	<u>Electric Motor</u> Hand Tractor PTO
Centrifugal Rotary Flowing Well	Windmill Other (specify): _____
Other (specify): _____	Horse Power Rating of Motor: <u>3HP</u>
Date Pump Installed: <u>7-13-07</u>	Setting Depth: <u>180FT Drop pipe</u> feet
Rated Pump Capacity: <u>35</u> Gallons Per Minute	Number of Stages: <u>10</u>

Pump Test Data	Method of Measuring Water Level Circle one
Date Well Tested: <u>7-13-07</u>	<u>Air Line</u> Electric Measuring Line Steel Tape
Static Water Level (A): <u>95</u> Feet Below Land Surface	Other (specify): _____
Pumping Water Level (B): <u>N/A</u> Feet Below Land Surface	For flowing well, measured shut in head: <u>N/A</u> feet
Drawdown [(B) - (A)]: <u>N/A</u> Feet Below Land Surface	Well yielded <u>60</u> GPM with a drawdown of
Test Pumping Rate: <u>38</u> Gallons Per Minute	<u>N/A</u> feet after <u>N/A</u> hours of pumping
Duration of Pump Test (minimum 4 hours): _____ hours	

I HEREBY CERTIFY that the above statements are true to the best of my knowledge.

Jack Ridgdell 0-472
 Print Name of Pump Installer and License No. (if applicable)

[Signature]
 Signature of Pump Installer