State W	rell Report	
	art 1	For Office Use Only:
Mississippi Departmen	t of Environmental Quality	Aquifer:
	nd Water Resources Box 10631	Well #: J-486
	IS 39289-0631	L. S. Elevation:
Date drilling completed: $1 - 15 - 08$ (601)	961-5210	
(601)354	4-6938 (fax)	E-log #:
State Law requires that this report be prepared by the 30 days of completion of drilling of the well.		
Well Owner Information		Location
Owner Name Billy Ray Havens	Latitude: <u>30° 30'549</u> " Longitude: <u>088° 45</u> , <u>009</u> "	
Mailing Address: 11413 Old Fort Bayou Rd	Method of Lat/Long (circle on	e): Conventional Survey,
		GPS, Survey-grade GPS
Vancleave, MS 39565 City State Zip Code	NE 1/4 SE 1/4 Sec 23	Twn T65 Rng R8W
Telephone No. <u>208) 376-06-32</u>	Distance Direction	Nearest Town of <u>VANCLEME</u>
Weil I	Data	
Purpose of Well (circle one Home Industrial Public Supply		Other:
	vell drilling completed:	15-08
If flowing, method of flow regulation: Valve $N/A$ Other (d		
Static Water Level:feet above on below (circle one) I		
Method of Measurement (circle one) steel tape electric tape	air line other:	
Hole depth: <u>180 FT</u> Well depth: <u>180 FT</u>	Well grouted to a depth of	[ Ofeet
Type of grout (circle one): Cement Bentonite Mix		0.1.
Casing length: <u>170</u> feet Casing diameter: <u></u>	inches Type of casing:	PVC
Screen length: feet Screen diameter:	inches Type of screen:	pvc
Screen slot size: <u>, , , , , , , , , , , , , , , , , , ,</u>	170 feet to	180 feet
Type of completion (circle all applicable): Gravel packed Under	reamed Telescoped Open	hole Natural Development
Other (describe):		
Top of lap pipe or reduction in casing: $N/A$ feet. If te	lescoped or more than one scre	een, describe on back of page
Logs run (circle all applicable). No log run Electric Gamma Ray	Density Sonic Neutron	Other:
Name of organization running log(s): NIA I certify that the well was drilled, constructed, and completed in a	accordance with all applicable	requirements of the Mississippi
Department of Environmental Quality and/or the Mississippi De	partment of Health regulations	and state laws.
2 - Frank		PIL
Jack Ridgdell 0-472	Join	Fighell
Tack Ridgdell 0-472 Print Name of Water Well Contractor and License No.	Signature of	Keldell Water Well Contractor

• . • .

> GREET 2006 BY OLWR


J-486

If well telescopes please sketch below and show depths.

Ground Level

evel	Description of Formations Encountered	From To
	TOPSOIL	
	Orlinge Clay	-33
	Bround Coarse Sand	30 55
	Blueclay	55 130
	Bray Course Sand	130180
	······································	
		┉┈┙┹┈╌╌┛

If more than one screen, show location of each on sketch

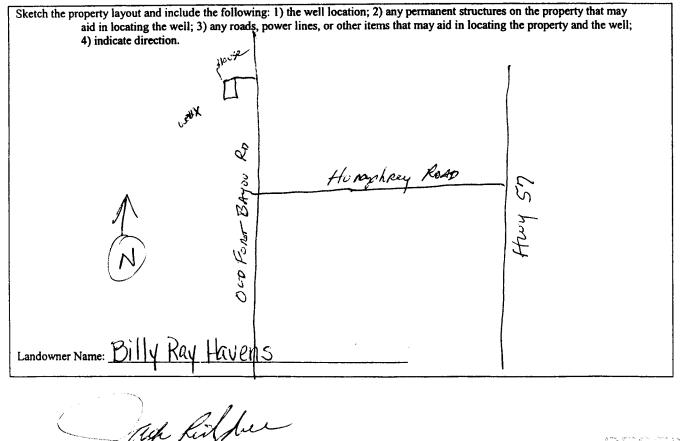

Signature of Water Well Contractor

L

RECEIVED FELICIES BYLOCWER

		STATE W	ELL REPORT	
County Jackse Permit #: Driller MS+ WA Date completed: [-]	ter well si	Part 2 Pump Installer's Completion Report Mississippi Department of Environmental Quality Office of Land and Water Resources P.O. Box 10631 Jackson, MS 39289-0631 (601)961-5210 (601)354-6938 (fax)		For Office Use Only: Aquifer: Well #: J-486 Elevation:
This report shou installation of pa		y the pump installer in deta	ail and filed with the Departn	nent within 30 days of the
Well Owner Information		Well Location		
Owner Name: Billy Ray Havens		Latitude: 10° 30' 549" Longitude: 088 45' 00		
Mailing Address: 1413 Old For + Bayou Rd.		Method of Lat/Long (circle one): Conventional Survey,		
		,	USGS quad, Har	nd-held GPS, Survey-grade GPS
Vancleave Ms 39565		NE 1/ SE 1/ Sec 23 Twn TES Rng R 8W		
Cit	City State Zip Code		Distance Direction Nearest Town	
Telephone No. <u>228</u> 826 - 0632		31/2 Miles AUCST of Vancleave		
	Pump Type		P	ower Type
	Circle one			Circle one
Air Lift	(Jet)	Submersible	Diesel Engine Gasol	ine Engine Natural Gas
Bucket	Piston	Turbine	Electric Motor Hand	Tractor PTO
Centrifugal	Rotary	Flowing Well	Windmill Other	r (specify):
Other (specify):			Horse Power Rating of Moto	or: 1 HF
Date Pump Installed:	1-17-0	8	Setting Depth: <u>HOFT. Droppipe</u> , feet	
	•	Gallons Per Minute	Number of Stages:	<u><u></u><u></u><u></u><u></u><u></u><u></u><u></u><u></u><u></u><u></u><u></u><u></u><u></u><u></u><u></u><u></u><u></u><u></u><u></u></u>
Pump Test Data		Method of Measuring Water Level		
Date Well Tested:	1-17-08	)		Circle one
Static Water Level (A)	): <u>20</u> F	eet Below Land Surface		easuring Line Steel Tape
Pumping Water Level	(B): NA F	eet Below Land Surface	Other (specify):	
Drawdown [(B) - (A)]	:_ <u>N/A_</u> F	eet Below Land Surface	For flowing well, measured s	shut in head: $N/A$ feet
Test Pumping Rate:Gallons Per Minute		Well yielded 9	GPM with a drawdown of	
		rs):hours	NA_feet after	. 3
Thereby certify	that the above sta	tements are true to the best o	f my knowledge.	
JUNULIN			vome vice	****

• •

RANG CAR