State W	/ell Report						
County: MICLESEN A	For Office Use Only:						
Mississippi Departmen	at of Environmental Quality Aquifer:						
	and Water Resources Box 10631 Well #: <u>J-500</u>						
Jackson, IV.	1S 39289-0631 L. S. Elevation:						
	961-5210 54-6938 (fax) E-log #:						
State Law requires that this report be prepared by the 30 days of completion of drilling of the well.	State Law requires that this report be prepared by the driller in detail and filed with the Department within						
Well Owner Information	Well Location						
Owner Name Michael Barton	Latitude: <u>30° 31 ' (400</u> ' Longitude: <u>088° 44</u> ' <u>579</u> '						
Mailing Address: Scaman Rd.	Method of Lat/Long (circle one): Conventional Survey,						
	USGS quad, Hand-held GPS Survey-grade GPS						
Vancleave MS 39565 City State Zip Code	SE 1/2 NW 1/2 Sec 13 Twn T65 Rng R8 W						
Telephone No. <u>2083</u> 324 - 4975	Distance Direction Nearest Town <u>3</u> Miles <u>West</u> of <u>Vandeane</u>						
Weil	Data						
Purpose of Well (circle one) Home Industrial Public Supply	Irrigation Fish Culture Other:						
Date well drilling started: 5-12-08 Date w	well drilling completed: <u>5-12-08</u>						
If flowing, method of flow regulation: Valve N/A Other (d	lescribe)						
Static Water Level:feet above or below (circle one) I	and surface Date measured: 5-12-08						
Method of Measurement (circle one) steel tape electric tape	air line other:						
Hole depth: 500 FT Well depth: 500 FT	Well grouted to a depth offeet						
Type of grout (circle one): Cement Bentonite Mix							
Casing length: <u>485</u> feet Casing diameter: <u>2</u> inches Type of casing: <u>PVC</u>							
	Screen length: <u>15</u> feet Screen diameter: <u>2</u> inches Type of screen: <u>PVC</u>						
Screen slot size: <u>.006</u> inches Setting depth: From <u>485</u> feet to <u>500</u> feet							
Type of completion (circle all applicable): Gravel packed Underreamed Telescoped Open hole Natural Development							
Other (describe):							
Top of lap pipe or reduction in casing: <u>NA</u> feet. If telescoped or more than one screen, describe on back of page							
Logs run (circle all applicable) No log run Electric Gamma Ray Density Sonic Neutron Other:							
Name of organization running log(s): NA I certify that the well was drilled, constructed, and completed in accordance with all applicable requirements of the Mississippi							
Department of Environmental Quality and/or the Mississippi Department of Health regulations and state laws.							
Jack Ridgdell 0-472 Jack Right							
Print Name of Water Well Contractor and License No.	Signature of Water Well Contractor						

5 7 4 5

> UN 352008 SY: O LVV P


J- 500

If well telescopes please sketch below and show depths.

١

Ground Level	G		From	To
Ground Level		Description of Formations Encountered TOP Soil Orange Clay Orange Clay Orange Clay Orange Clay Stray Medium Sand Slue Clay Stray Medium Sand Slue Clay Stray Coarse Sand Slue Clay Stray Coarse Sand Sray Coarse Sand Sray Coarse Sand	19 19 19 19 19 19 19 19 19 19 19 19 19 1	- - - - - - - - - - - - - -
	-			
	Ľ			

If more than one screen, show location of each on sketch

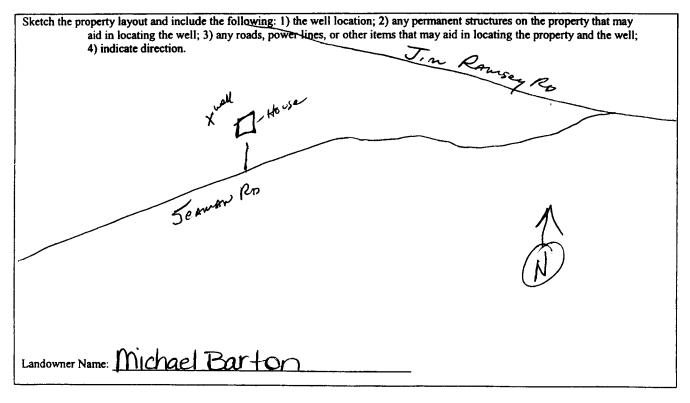

ul Signature of Water Well Contractor

SECENED JUN 0 5 2008

SY OLVE

County: Jackson	~	/ELL REPORT Part 2 er's Completion Report	For Office Use Only:	
Permit #:	Mississippi Departm	and Water Resources	Aquifer:	
Driller Coast Water Wellsry.	P.C). Box 10631	Well #: J-500	
Date completed: 5-13-08		, MS 39289-0631)1)961-5210		
	(601)	354-6938 (fax)	Elevation:	
This report should be prepared by th installation of pump.	e pump installer in de	etail and filed with the Departme	nt within 30 days of the	
Well Owner Informat	ion	Wel	Location	
OWNER Name: Michael Barto	n	Latitude: 30'31' 600'	Longitude: 088 44 '579"	
Mailing Address: Seaman Ro	4	Method of Lat/Long (circle on	e): Conventional Survey,	
		USGS quad, Hand	-held GPS Survey-grade GPS	
Vancleave M	15,395705		Twn TES Rng Rg W	
City State	Zip Code		Nearest Town	
178 2711 1/m	6		Vancleave	
relephone No. <u>208</u> 324 - 497	<u>ے</u>	Miles	VARCHERD	
Ритр Туре			ver Type	
Circle one		Ci	rcle one	
Air Lift Jet	Submersible	Diesel Engine Gasolin	e Engine Natural Gas	
Bucket Piston	Turbine	Electric Motor Hand	Tractor PTO	
Centrifugal Rotary	Flowing Well	Windmill Other (specify):	
Other (specify):		Horse Power Rating of Motor:	2 HP	
Date Pump Installed: <u>5-19-08</u>	3	Setting Depth: 20FT.D		
Rated Pump Capacity:	Gallons Per Minute	Number of Stages:3	111-	
Pump Test Data		Method of Mea	suring Water Level	
Date Well Tested: 5-13-08			rcle one	
Static Water Level (A): <u>100</u> Feet Below Land Surface Pumping Water Level (B): <u>N/A</u> Feet Below Land Surface		Air Line Electric Measuring Line Steel Tape Other (specify):		
Cest Pumping Rate:		For flowing well, measured shut in head: N/A feet		
•		Well yielded 22 GPM with a drawdown of		
Duration of Pump Test (minimum 4 hours):	.5hours	NAfeet after	NA hours of pumping	
		• • • • •		
HEREBY CERTIFY that the above stateme	ents are true to the best	ot my knowledge.		
John Elkins 0-4-		John Elkn	the grant of the second s	

, , ,

1	1	N	5	0008

SV. CLAR