	State W	ell Report					
County JECKSON	-	art 1	For Office Use Only:				
Permit #:		t of Environmental Quality	Aquifer:				
Driller (Dast Water Well SP	Office of Land and Water Resources P.O. Box 10631		Well #: J-503				
	Jackson, iv	IS 39289-0631	L. S. Elevation:				
Date drilling completed: $0-5-08$		961-5210 i4-6938 (fax)	E-log #:				
L							
State Law requires that this report be prepared by the driller in detail and filed with the Department within 30 days of completion of drilling of the well.							
Well Owner Informa		Wel	Location				
Owner Name Raymond Page		Latitude: <u>30° 29', 591</u> " Longitude: <u>088</u> 43 978					
Mailing Address: CHEVOKEE	Rose Rd.	Method of Lat/Long (circle one): Conventional Survey,					
	Usc		USGS quad Hand-held GPS Survey-grade GPS				
Vancleave, MS 39565 City State Zip Code		SE 1/2 NE1/2 Sec 26 Twn T65 Rng R&W					
Telephone No. 28 820 - 35	F	Distance Direction	Nearest Town of VAnclearer				
	Weil	l Data					
Purpose of Well (circle one Home Ind	ustrial Public Supply	Irrigation Fish Culture	Other:				
Date well drilling started: $u = 5-08$ Date well drilling completed: $u = 5-08$							
If flowing, method of flow regulation: Valve NIA_Other (describe)							
Static Water Level: <u>95</u> feet above of below circle one) land surface Date measured: <u>0-5-08</u>							
Method of Measurement (circle one) steel tape electric tape air line other:							
Hole depth: 375' Well depth: 375' Well grouted to a depth of 10 feet							
Type of grout (circle one): Cement Bentonite Mix							
Casing length: <u>365</u> feet Casing diameter: <u>A</u> inches Type of casing: <u>OVC</u>							
Screen length:							
Screen slot size: <u>e 000</u> inches Setting depth: From <u>305</u> feet to <u>375</u> feet							
Type of completion (circle all applicable): Gravel packed Underreamed Telescoped Open hole Natural Development							
Other (describe):							
Top of lap pipe or reduction in casing: NA feet. If telescoped or more than one screen, describe on back of page							
Logs run (circle all applicable) No log run Electric Gamma Ray Density Sonic Neutron Other:							
Name of organization running log(s): NIA							
I certify that the well was drilled, constructed, and completed in accordance with all applicable requirements of the Mississippi							
Department of Environmental Quality and/or the Mississippi Department of Health regulations and state laws.							
Jack Ridgdell O	-472	ahla	ffue				
Print Name of Water Well Contractor and	License No.	Signature of					
			JUL 0 3 2008				

BY: OLWR

T- 503

If well telescopes please sketch below and show depths.

Ground Level


	Description of Formations Encountered	From To
	100 501	03
	OPADOR CLAY	3 18
	Brown Coarse sand	18/00
	BUENOU	100 25
	Gray medium Sand	125/00
	Bueclau	190195
	Grau marium sand	
	Blue Clay	<u> 21537</u>
	Gray medium sand	13451313
		-+
		-+
1	-	

. ..

~ ~

at the England

If more than one screen, show location of each on sketch

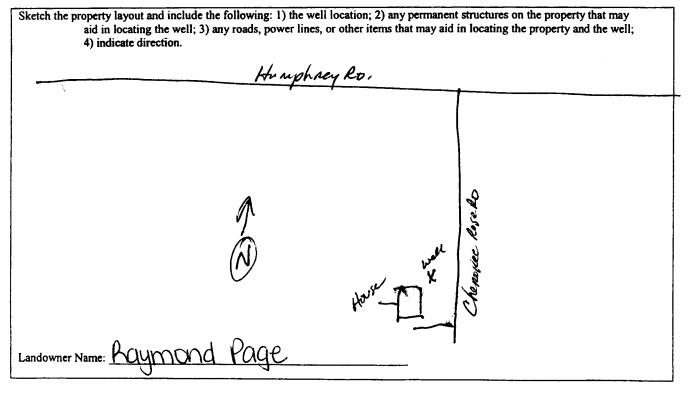

Signature of Water Well Contractor

RECEIVED JUL 0 3 2008 **BY: OLWR**

STATE WELL REPORT							
county: Jackson	Pump Installer's Mississippi Departmen	art 2 s Completion Report at of Environmental Quality and Water Resources	For Office Aquifer:	Use Only:			
Permit #: Driller(Dast Water Well SRV.	P.O. Box 10631 Jackson, MS 39289-0631 (601) 961-5210		Well #:	503			
Date completed: $0-5-08$	(601) 3	54-6938 (fax)	Elevation:				
This report should be prepared by th installation of pump.	e pump installer in deta			of the			
Well Owner Information							
	Dwner Name: Raymond Page		Latitude: 30° 29'591'' Longitude: 088° 43'978''				
Mailing Address: CNEY OKEE BU	Mailing Address: CHEYOKEE ROSE Rd.		Method of Lat/Long (circle one): Conventional Survey,				
		USGS quad Hand-held GPS Survey-grade GPS					
Vancleave, MS 39565 City State Zip Code		SE 1/ NE 1/2 Sec 26 Twn 76 5 Rng RBW					
	:0)		Distance Direction Nearest Town 3/2-Miles 56 of Vowcleave				
Telephone No. (205 824 - 35	<u>291</u>	<u></u>	f_VAuclear				
Pump Type Circle one			Power Type Circle one				
Air Lift (Jet)	Submersible			Natural Gas			
Bucket Piston	Turbine	Electric Motor Hand		Tractor PTO			
Centrifugal Rotary	Flowing Well	Windmill Other (specify):				
Other (specify):		Horse Power Rating of Motor:	<u>a HP</u>				
Date Pump Installed: <u>10-10-08</u>		Setting Depth: 100 FT drop preset					
Rated Pump Capacity: 9.5	Gallons Per Minute	Number of Stages:					
Pump Test Data Date Well Tested: Q - 1D - 08		Method of Measuring Water Level Circle one					
05	Balaw Land Surface	Air Line Electric Meas	suring Line S	iteel Tape			
Static Water Level (A): $\underline{\mathcal{N}}$ Feet Below Land Surface Pumping Water Level (B): \mathcal{N} Feet Below Land Surface		Other (specify):					
Drawdown [(B) – (A)]:Feet Below Land Surface		For flowing well, measured sh	ut in head: N/A	feet			
Test Pumping Rate: Gallons Per Minute		Well yielded <u>23</u> GPM with a drawdown of					
Duration of Pump Test (minimum 4 hours):	hours	NA feet after A	hours	of pumping			
I HEREBY CERTIFY that the above statements are true to the best of my knowledge.							
JACK BIDDELL Print Name of Pump Installer and License N	() - 472 lo. (if applicable)	Signature of Pump Ins	staller	RECEIVED			
		$\mathcal{O}^{$		JUL 0 3 2008			
				BY: OLWR			

.

.

.

Ŧ