State	Well Report	
County: Jackson	Part 1	For Office Use Only:
Mississippi Departr	nent of Environmental Quality	Aquifer:
	nd and Water Resources D. Box 10631	Well #:
Driller: Wart Wart Wart Jackson	, MS 39289-0631	L. S. Elevation:
	01) 961-5210) 354-6938 (fax)	E-log #:
	•	
State Law requires that this report be prepared by 30 days of completion of drilling of the well.	the driller in detail and filed w	with the Department within
Well Owner Information		l Location
Owner Name Regina Batia	Latitude: <u>30 • 38 ,857</u>	<u>1</u> " Longitude: <u>088 44,833</u> ,
Mailing Address: 8301 Shady Rest	Method of Lat/Long (circle or	
-	USGS quad Hand-held	GPS, Survey-grade GPS
Vancleave, MS 31565 City State Zip Code	50 1/2 NW1/4 Sec 36	Twn T65 RngR8W
Telephone No. (208, 326 - 11062	Distance Direction <u> ら</u> Miles <u></u> らい	Nearest Town
\sim	ell Data	
	y Irrigation Fish Culture	Other:
Date well drilling started: $(1 - 33 - 08)$ Dz	te well drilling completed:	2-33-08
If flowing, method of flow regulation: Valve NA Othe		
Static Water Level:feet above or below circle or	e) land surface Date measured:	6-23-08
Method of Measurement (circle one) steel tape electric t		
Hole depth: 175' Well depth: 175'	Well grouted to a depth of	10feet
Type of grout (circle one): Cement Bentonite M	lix	
Casing length:feet Casing diameter:	inches Type of casing:	PVC
Screen length: <u>5</u> feet Screen diameter: <u>2</u>	inches Type of screen:	pv.C
Screen slot size: / UOY_inches Setting depth: From	m_170feet to	75 feet
Type of completion (circle all applicable): Gravel packed Ur	derreamed Telescoped Open	hole Natural Development
Other (describe):		······
Top of lap pipe or reduction in casing: feet. I	f telescoped or more than one scr	een, describe on back of page
Logs run (circle all applicable): No log run Electric Gamma F	Ray Density Sonic Neutron	Other:
Name of organization running log(s): MA I certify that the well was drilled, constructed, and completed	in accordance with all annliashis	requirements of the Mississinni
Department of Environmental Quality and/or the Mississippi		
Jack Ridadell N-UTA	\bigcap	Africe
Print Name of Water Well Contractor and License No.	Signature of	Water Well Contractor
		RFCET/ET
		r Shares Dear Brance & M. Amerikan

• • • • • • •

> JUL 18 2008 BY: OLWR


1-505

If well telescopes please sketch below and show depths.

Ground

d Level		Description of Formations Encou	ntered	From	To A
	•	Grange Clay White Crarse San Orange I Blue Cla Gray Medium Sa	d Ka	30 60 167	30 60 167 175
]

If more than one screen, show location of each on sketch

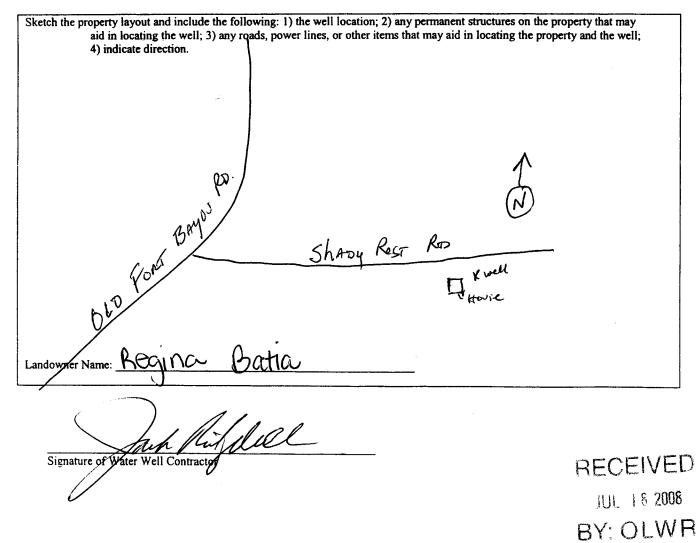

		ELL REPORT		
County: JACKSON Permit #: Driller: COOST WATEY WELL SRV.	Part 2 Pump Installer's Completion Report Mississippi Department of Environmental Quality Office of Land and Water Resources P.O. Box 10631 Jackson, MS 39289-0631 W		For Office Use Only: Aquifer: Well #:	
Date completed: $U - 23 - 08$			Elevation:	
This report should be prepared by the	ne pump installer in det	ail and filed with the Departme	ent within 30 days of the	
installation of pump. Well Owner Informat	tion		l Location	
Owner Name: Regina Batic	Latitude: 30°28'8		59 ^{''} Longitude: <u>0</u> 88°44′833	
Mailing Address: 8301 Shady		Method of Lat/Long (circle on	ne): Conventional Survey,	
		USGS quad, Hand	I-held GPS Survey-grade GPS	
Vancleave, MS 39545		SW 1/ NW 1/4 Sec 36 Twn 765 Rng R8W		
City State	Zip Code	Distance Direction	Nearest Town	
Telephone No. 2018 3210 - 101	e2	<u>5</u> Miles <u>5</u> o	f_VAncleave	
Pump Type Circle one			wer Type ircle one	
Air Lift Jet	Submersible	Diesel Engine Gasolin	ne Engine Natural Gas	
Bucket Piston	Turbine	Electric Motor Hand	Tractor PTC	
Centrifugal Rotary	Flowing Well	Windmill Other	(specify):	
Other (specify):		Horse Power Rating of Motor	L #P	
Date Pump Installed:	3	Setting Depth: <u>20 Ft</u> C	IDP DID Seet	
Rated Pump Capacity:		Number of Stages:	2	
Pump Test Data			asuring Water Level ircle one	
Date Well Tested: 0-24-08				
Static Water Level (A):Feet	Below Land Surface	Air Line Electric Mea		
Pumping Water Level (B): NA Feet	Below Land Surface	Other (specify):		
Drawdown [(B) - (A)]: N Feet		For flowing well, measured sh	nut in head: NAfeet	
<u>'</u> 1A	Gallons Per Minute	Well yielded <u>24</u>	•	
Duration of Pump Test (minimum 4 hours):	hours		N A hours of pumping	
I HEREBY CERTIFY that the above staten	nents are true to the best	of my knowledge.	1/1 -	
Jack Ridgdell D-1	472	Signature of Pump In	11	
Print Name of Pump Installer and License N	vo. (11 applicable)			
		V	JUL 1	
			BY: O	

-