State W	ell Report
	For Office Use Only:
Mississippi Departmen	t of Environmental Quality Aquifer: <u>5.538</u>
P.O. E	Box 10631 Well #:
Jackson, M	IS 39289-0631 L. S. Elevation:
Bank of the Bank o	E-log #:
State Law requires that this report be prepared by the 30 days of completion of drilling of the well.	driller in detail and filed with the Department within
Well Owner Information	29 Well Location 61
Owner Name Connie Mallette	Well Location 61 Latitude: <u>30° 32 (277</u> " Longitude: <u>088° 44' 847</u> "
Mailing Address: Jim Ramsey Rd.	Method of Lat/Long (circle one): Conventional Survey,
	USGS quad, fland-held GPS, Survey-grade GPS
Vancleave, MS 39565 City State Zip Code	NW 1/4 NW Sec 12 Twn TGS Rng R8W
City State Zip Code Telephone No. <u>228) 826 - 0809</u>	Distance Direction Nearest Town <u>3 h</u> Miles west of Vawcleans
Weil	Data
Purpose of Well (circle one) Home Industrial Public Supply	Irrigation Rish Culture Other: Aoud
Date well drilling started: <u>4-27-10</u> Date w	vell drilling completed: <u>4-27-10</u>
If flowing, method of flow regulation: Valve Other (d	
Static Water Level:feet above or below (circle one) I	and surface Date measured: $4 - 27 - 10$
Method of Measurement (circle one) steel tape electric tape	
Hole depth: <u>63FT.</u> Well depth: <u>63FT.</u>	Well grouted to a depth offeet
Type of grout (circle one): Cement Bentonite Mix	<i>pulc</i>
Casing length: <u>48</u> feet Casing diameter: <u>4</u>	
Screen length: <u>15</u> feet Screen diameter: <u>4</u>	inches Type of screen: $\underline{PVC}$
Screen slot size: • 008 inches Setting depth: From _	<u>48</u> feet to <u>63</u> feet
	reamed Telescoped Open hole Natural Development
Top of lap pipe or reduction in casing:	escoped or more than one screen, describe on back of page
Logs run (circle all applicable: No log run) Electric Gamma Ray	Density Sonic Neutron Other:
Name of organization running log(s): N/A I certify that the well was drilled, constructed, and completed in a	recordance with all applicable requirements of the Mississiumi
Department of Environmental Quality and/or the Mississippi De	
Jack Ridgdell 0-472	
Print Name of Water Well Contractor and License No.	Signature of Water Well Contractor
	「「「「「」」「「」」「「」」」「「」」」「「」」」「「」」」」」「「」」」」」

· · ·

|--|

J538

If well telescopes please sketch below and show depths.


## Ground Level

•.

•

Description of Formations Encountered	From	То
 TODSOIL	$\top 0$	
pranae clay		20
hrange Coalise Sand	50	63
proceeding of the second		
and the second		
	~ <del> </del>	
	+	
	+	
		<b> </b>
	+	
	T	
	1	
	1	
	1	
······································	+	<u>├ </u>
	+	
	+	┝───┥
	1	L]

If more than one screen, show location of each on sketch

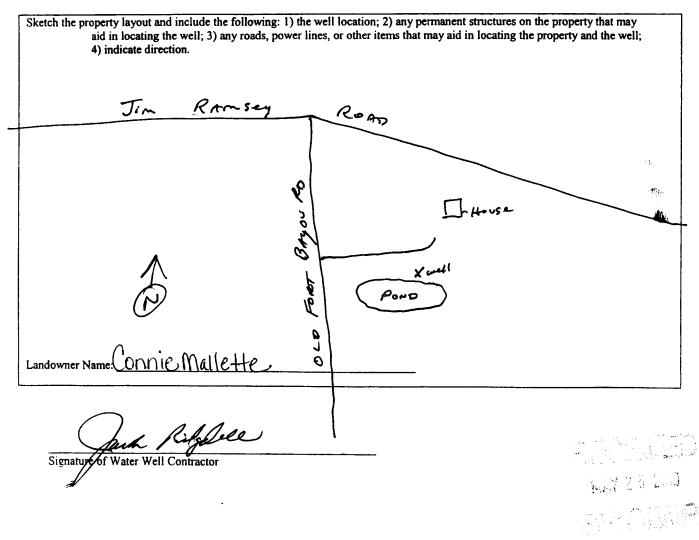

	STATE WELL RE	PORT	J528	
County: Tackson	Part 2 Pump Installer's Completion Mississippi Department of Environ Office of Land and Water R. P.O. Box 10631	mental Quality Aquife esources		
Driller COAST WARR Well Service Date completed: 4-2,7-10	Jackson, MS 39289-0631 (601) 961-5210 (601) 354-6938 (fax)		Well #:	
This report should be prepared by th	e pump installer in detail and filed	with the Department withi	n 30 days of the	
installation of pump. Well Owner Informat	ion	Well Location	on	
Owner Name: Connie Mallette	Latitude	30°32′637″ Longitu	ude: <u>08° 44'847</u> 4	
Mailing Address: Jim Ramsey Ro	A, Method of	Lat/Long (circle one): Con	ventional Survey,	
/		USGS quad, Hand-held GF	PS, Survey-grade GPS	
Varcleave, Ms.	39565 NW 1/4	NW 1/4 Sec 12 Twi	T65 Rng R8W	
City State	Zip Code Distance	Direction Nea	rest Town	
Telephone No. <u>828) 826 - 080</u>	3/2	Miles West of VA	nelenne	
Pump Type Circle one		Power Typ Circle one		
Air Lift Jet 🤇	Submersible Diesel Eng	gine Gasoline Engine	e Natural Gas	
Bucket Piston	Turbine Electric M	otor Hand	Tractor PTO	
Centrifugal Rotary	Flowing Well Windmill	Other (specify):		
Other (specify):	Horse Pow	ver Rating of Motor:	ρ	
Date Pump Installed: 4-28-10	Setting De	pth: 40FT. Drop Pipe	feet	
Rated Pump Capacity: 20	Gallons Per Minute Number of	Stages: 9		
Pump Test Data		Method of Measuring Circle one	Water Level	
Date Well Tested: 4-28-10	AirLine	Electric Measuring Li	ne Steel Tape	
Static Water Level (A):Feet	Below Land Surface	cify):	-	
Pumping Water Level (B): <u>NA</u> Feet I	Below Land Surface			
Drawdown [(B) – (A)]: $N A$ Feet	Below Land Surface For flowin	g well, measured shut in hea	d: <u>N/A</u> feet	
Test Pumping Rate: 24	Gallons Per Minute Well yield	ed <u>40</u> GPM	with a drawdown of	
Duration of Pump Test (minimum 4 hours):	hours	A feet after N	Ahours of pumping	
I HEREBY CERTIFY that the above statem	ents are true to the best of my knowle	dge.		
TI OIL JUL A UNA		La Retidee		
Print Name of Pump Installer and License N		gnature of Pump Installer	the second s	