

STATE WELL REPORT

63

County: JACKSON
 Permit #: _____
 Driller: Coast Water Well Service
 Date drilling completed: 1-21-2021

Part 1
Driller's Log
 Mississippi Department of Environmental Quality
 Office of Land and Water Resources
 P.O. Box 2309
 Jackson, MS 39225-2309
 (601)961-5210
 (601)360-0535 (fax)

For Office Use Only:
 Well #: J 710
 Aquifer: _____
 E-Log #: _____

State Law requires that this report be prepared by the license holder responsible for the work and filed with the Department at the above address within 30 days of completion of drilling of the well or borehole.

Well Owner Information <small>(Landowner if borehole is not for a water well)</small>	Well or Borehole Location
Owner Name: <u>Farve's Pump & Well Service</u>	Latitude: <u>N 30° 32.699</u> Longitude: <u>W 088° 52.145</u> <u>30 32 39</u> <u>88 52 10.5</u>
Mailing Address: <u>Old B. Top Road</u>	Method of Lat/Long (check one): Conventional Survey _____
<u>Vancelevue</u> <u>MS</u> <u>39565</u>	USGS quad _____, Hand-held GPS <input checked="" type="checkbox"/> , Survey-grade GPS _____
City State Zip Code	<u>56 NE</u> 1/4 <u>SE</u> 1/4, Sec. <u>3 10</u> T <u>65</u> R <u>9w</u>
Telephone No. (<u>228</u>) <u>731-2112</u>	<u>10.5</u> Miles <u>West</u> of <u>Vancelevue</u> (Distance) (Direction) (Nearest Town)

Well / Borehole Data

Date drilling started: 1-19-2021 Date drilling completed: 1-21-2021 Hole depth: 470' Hole diameter: 4x2

Location of the source of any surface water used for drilling: (OUR SHOP WELLS - NO SURFACE)

Method of dosing and volume of Chlorine used in drilling and development: 1 gallon per 1000 gallons

Logs run (circle all applicable): No log run Electric Gamma Ray Density Sonic Neutron Other: _____

Name of organization running log(s): N/A

Purpose of borehole (circle one) Water Well Geotechnical/Geological Investigation Ground Source Heat Pump
 Seismic Survey Other (describe) _____

If drilling is not related to water well construction, skip the remainder of this block

Purpose of Well (circle all applicable): Home Industrial Public Supply Irrigation Fish Culture

Other (describe): Commercial Building supply

If a flowing well, method of flow regulation: Valve _____ Other (describe) N/A

Static Water Level: 55' feet [above or below] land surface Date measured: 1-21-2021
(circle one)

Method of measurement (circle one): Steel tape Electric tape Air line Other (describe): _____

Well depth: 470 Well grouted to a depth of: _____ feet Type of grout (circle one): Neat Cement Bentonite Mix

Casing length: 4" 200' 2" 250' feet Casing diameter: 4" & 2" inches Type of casing: PVC F480

Screen length: 20 feet Screen diameter: 2" inches Type of screen: PVC Sch 80

Screen slot size: .006 inches Setting depth: From 450 feet to 470 feet

Type of completion (circle all applicable): Gravel packed Underreamed Open hole Natural Development

Other (describe): _____

Top of lap pipe or reduction in casing: 200 feet 200'


If telescoped or more than one screen, describe on next page

RECEIVED
 FEB 08 2021
 BY OLWR

County: JACKSON
Permit #: _____

For Office Use Only:
Well #: _____


The sketch below only required for water wells
If well telescopes, show depths on sketch.

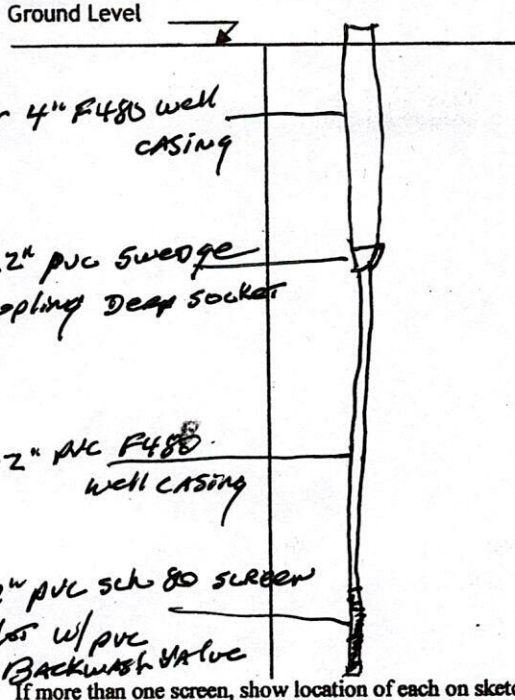

Description of formations encountered must be provided for all wells and boreholes, unless specifically exempted by regulations

Description of Formations Encountered	From (depth)	To (depth)
Top soil	Ground level	2
ORANGE CLAY	2	50
GRAY COARSE SAND	50	95
Blue Clay	95	435
GRAY COARSE SAND	435	470

- Sketch the property layout and include the following:
- 1) the well location
 - 2) any permanent structures on the property that may aid in locating the well
 - 3) any roads, power lines, or other items that may aid in locating the property and the well
 - 4) north arrow

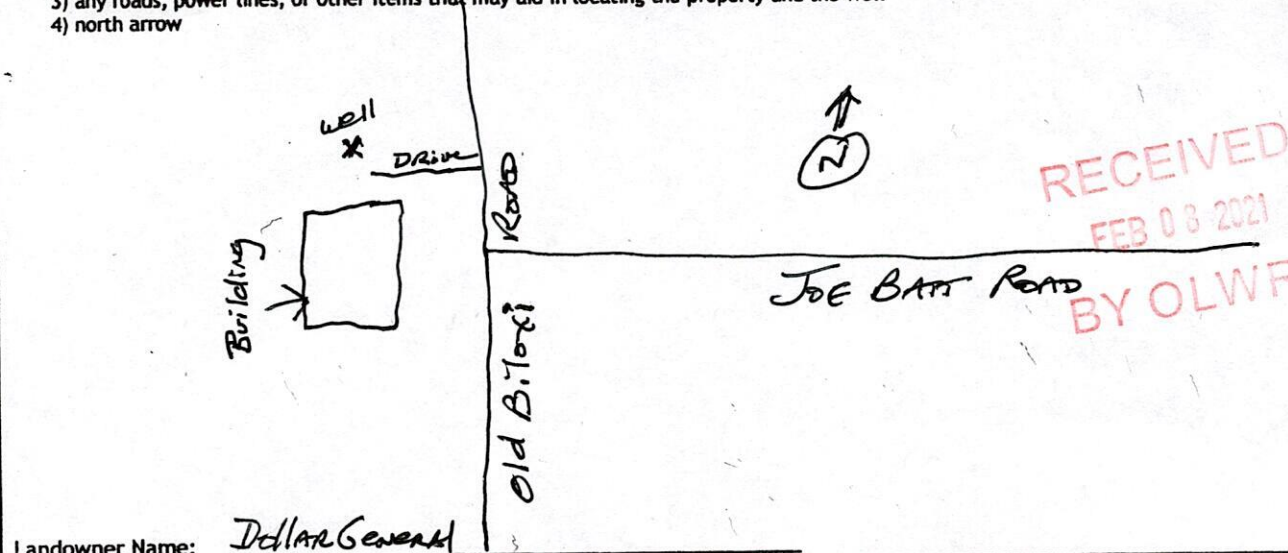

I HEREBY CERTIFY that the well/borehole was drilled, constructed, and completed in accordance with all applicable requirements of the Mississippi Department of Environmental Quality and the Mississippi Department of Health regulations, if applicable, and state laws.

JACK RIDGDELL 0-472 1-26-2021 Jack Ridgdel
Print Name of Responsible Licensee and License No. Date Signature of Licensee

STATE WELL REPORT

Part 2

Pump Installer's Completion Report
 Mississippi Department of Environmental Quality
 Office of Land and Water Resources
 P.O. Box 2309
 Jackson, MS 39225-2309
 (601)961-5210
 (601) 360-0535 (fax)

County: JACKSON
 Permit #: _____
 Driller: Faure Pump & Well
 Date completed: 1/25/2021
Copy information from block on Part 1

For Office Use Only:

Well #: J 710
 Aquifer: _____

This part of the report must be completed by a licensed water well contractor or a licensed pump installer. A copy of Part 1 of the report must be attached and both parts filed with the Department at the above address within 30 days of well completion.

Well Owner Information	Well Location
Owner Name: <u>Black Burn Const. (Dollar G)</u>	Latitude: <u>N30° 32.699</u> Longitude: <u>W088° 52.145</u>
Mailing Address: <u>Old Biloxi Rd.</u>	Method of Lat/Long (check one): Conventional Survey _____, ^{30 32 39} <u>USGS quad _____, Hand-held GPS <input checked="" type="checkbox"/>, Survey-grade GPS _____</u>
<u>Vanceleve</u> MS <u>39565</u>	<u>SE</u> ¼ <u>SE</u> ¼, Sec <u>3</u> T <u>65</u> R <u>9W</u>
City State Zip Code	<u>10.5</u> Miles <u>WEST</u> of <u>Vanceleve</u>
Telephone No. <u>(602) 701-0097</u>	(Distance) (Direction) (Nearest Town)

Pump Type (circle one)

Submersible Turbine Air Lift Centrifugal Flowing Well Jet Piston Rotary Other (describe): _____

Date Pump Installed: 1/25/2021 Rated Pump Capacity: 18 Gallons Per Minute

Is This Pump (circle one): New Repaired Replacement

Power Type (circle one)

Electric Diesel Gasoline Natural Gas Tractor PTO Windmill Other (describe): _____

Horse Power Rating of Motor: 1HP Setting Depth: 60 feet Number of Stages: 6

Pump Test Data for Non Flowing Well

Date Well Tested: 1/25/2021 Duration of Pump Test (minimum 4 hours): 6 hours

Static Water Level (A): 30 Feet Below Land Surface Pumping Water Level (B): 40 Feet Below Land Surface

Drawdown [(B) - (A)]: 10 Feet Below Land Surface Test Pumping Rate: 18 Gallons Per Minute

Method of measurement (circle one): Steel tape Electric tape Air line Other (describe): _____

Pump Test Data for Flowing Well

Measured shut in head: _____ feet. N/A

Well yielded _____ GPM with a drawdown of _____ feet after _____ hours of pumping

Meter Installation

Meter Manufacturer: N/A Meter Serial Number: _____

Meter Model Number/Name: _____ Type of Meter: _____

Totalizer Register Unit and Multiplier Factor (AF x .001, gal x 1000, etc): _____

Installation Date: _____ Meter installed by: _____

Is This Meter (circle one): New Repaired Replacement

Important: By submitting the above information you are certifying that this meter was installed to manufacturer standards. For agricultural wells, a list of approved meters is on the MDEQ website.

RECEIVED
 MAR 24 2021
 BY OLWR

I HEREBY CERTIFY that the above statements are true to the best of my knowledge.

Billy Faure RPO-00006792 1/25/2021 _____

Print Name of Pump Installer and License No. (if applicable) Date Signature of Pump Installer