

JACKSON

J 2001

6-17-75

MISSISSIPPI
 BOARD OF WATER COMMISSIONERS
 416 North State Street
 Jackson, Mississippi 39201

135

WATER WELL DRILLERS LOG

COAST WATER WELL SERVICE INC.

6/17 1975
date well completed

firm name

Jackson
county well located

LANDOWNER: Hill Home # 8

P.O. Box 854

Ocean Springs, Miss.
(mailing address)

WELL LOCATION:

sec. 29 T-6 N R-8 E
 4 1/2 miles NW of Ocean Springs
 (distance) (direction) (nearest town)

WELL PURPOSE: Home
(home, irrigation, municipal, industrial)

WELL COMPLETION DATA:

- (1) diameter (inches) 2"
- (2) total depth (feet) 180
- (3) static water level (feet) 8 below top of ground
- (4) casing PVC 170 (material) (depth)
2" (size) if telescope see back.
- (5) screen 10' 170 (length) (depth to top)
2" PVC (size) (material)
- (6) pump 1/2 7 (HP) (yield gpm)
elec. (type power)
- (7) electric log No (yes or no)
(organization running log)
- (8) how well bottom plugged B W U

description of formations encountered

from

to

top soil 0 8

clay 8 39

sand - c 39 121


clay 121 124

sand - c 124 129

clay 121 148

sand - c 148 180

DRILLERS REMARKS:

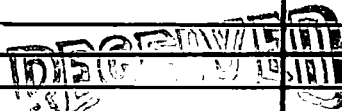


APR - 8 1975

MISSISSIPPI BOARD OF WATER COMMISSIONERS

If well telescopes please sketch and show depths.

GROUND LEVEL

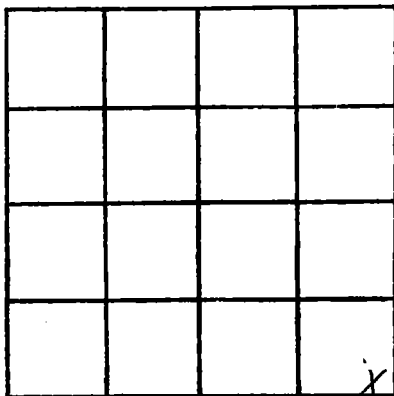

SECTION 29

Please indicate well location X.

ADDITIONAL INFORMATION

If more than one screen, show locations of each on sketch.