

JACKSON
J 2000
8-4-75

MISSISSIPPI
BOARD OF WATER COMMISSIONERS
416 North State Street
Jackson, Mississippi 39201

135

WATER WELL DRILLERS LOG

8/4 1975 COAST WATER WELL SERVICE INC. Jackson
date well completed firm name county well located

LANDOWNER: Hill Home # 9

P.O. Box 854

Ocean Springs, Miss
(mailing address)

WELL LOCATION:

sec 29 T 2 R 8 E
4 1/2 miles NE of Ocean Springs
(distance) (direction) (nearest town)

WELL PURPOSE: Home
(home, irrigation, municipal, industrial)

WELL COMPLETION DATA:

- (1) diameter (inches) 2"
- (2) total depth (feet) 180
- (3) static water level (feet) 12 below above top of ground.
- (4) casing PVC 170
(material) (depth)
2"
(size) If telescope see back.
- (5) screen 10 170
(length) (depth to top)
2" PVC
(size) (material)
- (6) pump 1/2 7
(HP) (yield gpm)
elec
(type power)
- (7) electric log NO
(yes or no)
(organization running log)
- (8) how well bottom plugged BWU

description of formations encountered

from to

top soil 0 8

clay 8 39

sand - c 39 121


clay 121 124

sand - c 124 129

clay 129 148

sand - c 148 180

DRILLERS REMARKS:

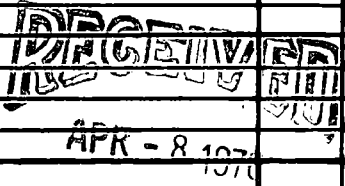

MISS. BD. OF WATER COMMISSIONERS

If well telescopes please sketch and show depths.

GROUND LEVEL

| | | | |
|--|--|--|---|
| | | | |
| | | | |
| | | | |
| | | | X |

SECTION 29

Please indicate well location X.

ADDITIONAL INFORMATION

If more than one screen, show locations of each on sketch.