

JACKSON
 J 2004
 9-19-75

MISSISSIPPI
 BOARD OF WATER COMMISSIONERS
 416 North State Street
 Jackson, Mississippi 39201

WATER WELL DRILLERS LOG
 GARLAND WATER WELLS

SEPTEMBER 19 1975
 date well completed

firm name


JACKSON
 county well located

LANDOWNER: ROY H. ROGERS RT 3, Box 223 Biloxi, Ms (mailing address)	description of formations encountered	from	to
WELL LOCATION: sec 35 T 46 S R 9 4 miles NORTH of GREEN SPRING (distance) (direction) (nearest town)	TOP SOIL	0	2
WELL PURPOSE: HOME (home, irrigation, municipal, industrial)	MUD	2	8
WELL COMPLETION DATA: (1) diameter (inches) 2"	COURSE SAND	8	110
(2) total depth (feet) 440'	MUD	110	125
(3) static water level (feet) 36' below top of ground	COURSE SAND	125	151
(4) casing PVC, 430' (material) (depth)	MUD	151	192
2" (size) if telescope see back.	FINE SAND	172	211
(5) screen 10' 430'-440' (length) (depth to top)	CLAY	211	223
2" (size) PVC (material)	FINE SAND & MUD STREAKS	223	391
(6) pump 1/2 HP, 12-14 (yield gpm)	COURSE S/P SAND	391	445
Electric (type power)	MUD	445	
(7) electric log No (yes or no)			
(organization running log)			
(8) how well bottom plugged Float Ball			
DRILLERS REMARKS:			

SEP 15 1975
 MISS. BD. OF WATER COMM.

If well telescopes please sketch and show depths.

GROUND LEVEL

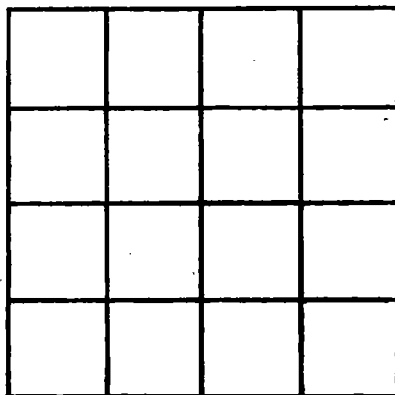

SECTION _____

Please indicate well location X.

ADDITIONAL INFORMATION

If more than one screen, show locations of each on sketch.