

JACKSON
 J 70X
 11-23-75

MISSISSIPPI
 BOARD OF WATER COMMISSIONERS
 416 North State Street
 Jackson, Mississippi 39201

WATER WELL DRILLERS LOG
 GARLAND WATER WELLS

NOVEMBER 23 1975
 date well completed

firm name

JACKSON
 county well located

LANDOWNER: W. H. SMITH
 RT 5, Box 236U
 OCEAN SPRINGS, Ms. 39564
 (mailing address)

WELL LOCATION:
 sec. 35 T. 26 S. R. 9 E
 4 miles NORTH of OCEAN SPRINGS
 (distance) (direction) (nearest town)

WELL PURPOSE: Home
 (home, irrigation, municipal, industrial)

- WELL COMPLETION DATA:
- diameter (inches) 2"
 - total depth (feet) 378'
 - static water level (feet) 45' below top of ground
 - casing PVC, 368' (depth)
 2" (size) if telescope see back.
 - screen 10' (length) 368' (depth to top)
 2" (size) PVC (material)
 - pump 1 (HP) 10-12 (yield gpm)
 Electric (type power)
 - electric log No (yes or no)
 N/A (organization running log)
 - how well bottom plugged Float Ball


description of formations encountered	from	to
TOP Soil	0	2
MUD	2	8
COURSE SAND	8	108
MUD	108	126
FINE SAND	126	173
CLAY	173	186
FINE SAND	186	215
MUD	215	271
FINE SAND	271	318
MUD	318	335
FINE SAND	335	341
MUD	341	347
COURSE SIP SAND (MED)	347	381
MUD	381	

DRILLERS REMARKS:

DISCONTINUED
 DEC 15 1975
 MISS. BD. OF WATER CO.

If well telescopes please sketch and show depths.

GROUND LEVEL

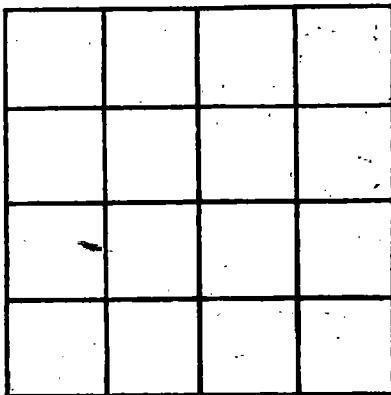

SECTION _____

Please indicate well location X.

ADDITIONAL INFORMATION

If more than one screen, show locations of each on sketch.