

JACKSON  
J 2007  
12-24-75

MISSISSIPPI  
 BOARD OF WATER COMMISSIONERS  
 416 North State Street  
 Jackson, Mississippi 39201

WATER WELL DRILLERS LOG  
 COASTAL DRILLING & SERVICE CO.

12/24 1975 date well completed  
 ROUTE 1 BOX 648 Jackson county well located

LANDOWN: H.P. Cuthbert  
John Ramsey Rd  
Bilal, Miss  
 (mailing address)  
 WELL LOCATION:  
 sec 18 T 6 N R 8 W  
2 1/2 miles EAST of ATIMER  
 (distance) (direction) (nearest town)

description of formations encountered	from	to
top soil	1	3
red clay	3	15
white sand	15	35
Soft Blue Clay	35	210
glau	210	265
Soft Blue Clay	265	310
very hard blue clay	310	460
Rocky hard clay	460	465
fine Water Sand	465	500
Coarse Water Sand	500	545

WELL PURPOSE: Home - Store  
 (home, irrigation, municipal, industrial)

- WELL COMPLETION DATA:
- (1) diameter (inches) 4 1/2"
  - (2) total depth (feet) 545'
  - (3) static water level (feet) 45 below above top of ground.
  - (4) casing gal, 530'  
 (material) (depth)  
4 1/2" If telescope see back.  
 (size)
  - (5) screen 15', 530'  
 (length) (depth to top)  
2", SS.  
 (size) (material)
  - (6) pump One Sub, 20  
 (HP) (yield gpm)  
5hp  
 (type power)
  - (7) electric log no  
 (yes or no)

(organization running log)


(8) how well bottom plugged  
2" hard pack below

DRILLERS REMARKS:  
none

DECEMBER 25  
 MAR 17 1976

If well telescopes please sketch and show depths.

GROUND LEVEL

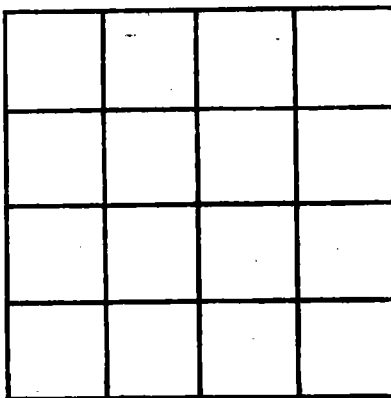

SECTION \_\_\_\_\_

Please indicate well location X.

ADDITIONAL INFORMATION

A series of 18 horizontal lines provided for entering additional information.

If more than one screen, show locations of each on sketch.