

JACKSON

J 7009

1-23-76

MISSISSIPPI BOARD OF WATER COMMISSIONERS 416 North State Street Jackson, Mississippi 39201

WATER WELL DRILLERS LOG

1/23 1976 date well completed

COAST WATER WELL SERVICE INC. firm name

Jackson county well located

LANDOWNER: Hill Homes for 2

P.O. Box 854

Ocean Springs Miss (mailing address)

WELL LOCATION:

sec. 29 T-6 R-8 4 1/2 miles NE of Ocean Springs (distance) (direction) (nearest town)

WELL PURPOSE: Home (home, irrigation, municipal, industrial)

WELL COMPLETION DATA:

- (1) diameter (inches) 2"
(2) total depth (feet) 180'
(3) static water level (feet) 10 below top of ground.
(4) casing PVC, 170' (material) (depth) 2" (size) if telescope see back.
(5) screen 10' 170' (length) (depth to top) 2" PVC (size) (material)
(6) pump 1/2 7 (HP) (yield gpm) elec. (type power)
(7) electric log NO (yes or no)
(organization running log)
(8) how well bottom plugged BWU

Table with 3 columns: Description of formations encountered, from, to. Rows include: top soil (0-8), Blue clay (8-39), Sand (C) (39-121), Blue clay (121-124), Sand - (C) (124-129), Blue clay (129-148), Sand (C) (148-180).


DRILLERS REMARKS:

APR 1976

MISS. BOARD OF WATER COMM

If well telescopes please sketch and show depths.

GROUND LEVEL

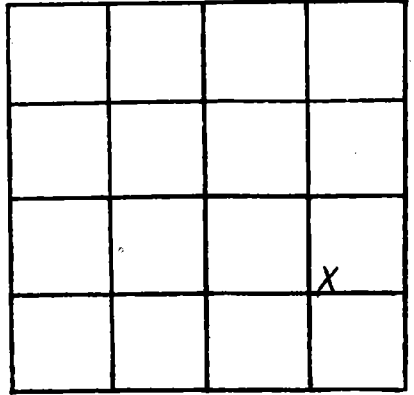

SECTION 29

Please indicate well location X.

ADDITIONAL INFORMATION

If more than one screen, show locations of each on sketch.