

JACKSON
 J 2013
 2/28/76
 2/28/76
 date well completed

MISSISSIPPI
 BOARD OF WATER COMMISSIONERS
 416 North State Street
 Jackson, Mississippi 39201

WATER WELL DRILLERS LOG
 COASTAL DRILLING & SERVICE CO.

ROUTE 1 BOX 618
 Jackson county well located

LANDOWNER: Ray people
 RT 5
 Biloxi, Miss.
 (mailing address)

description of formations encountered	from	to
Top Soil	1	3
Red Clay	3	15
white sand	15	40
Soft Blue Clay	40	210
Light water Sand	210	230
Soft Blue Clay	230	300
hard Blue Clay	300	390
Coarse water Sand	390	395
very hard Blue Clay	395	400
Light water Sand	400	445
Coarse water Sand	445	445

WELL LOCATION:
 sec. 34 T. 6 N. R. 9 E.
 2 1/2 miles (distance) S of (direction) Latimer (nearest town)

WELL PURPOSE: home
 (home, irrigation, municipal, industrial)

WELL COMPLETION DATA:

(1) diameter (inches) 2"

(2) total depth (feet) 445'

(3) static water level (feet) 30 below above top of ground.

(4) casing PVC, 435'
 (material) (depth)
 (size) If telescope see back.

(5) screen 10', 435'
 (length) (depth to top)
2", PVC
 (size) (material)


(6) pump One, 15
 (HP) (yield gpm)
Ele
 (type power)

(7) electric log no
 (yes or no)

(organization running log)

(8) how well bottom plugged
2" lead wire

DRILLERS REMARKS:
none

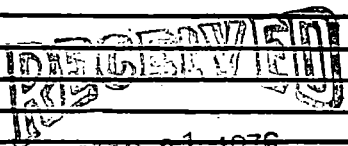


MAR 31 1976

MISS. BD. OF WATER COMMISSIONERS

If well telescopes please sketch and show depths.

GROUND LEVEL

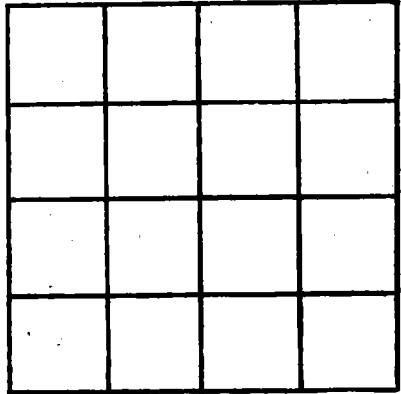

SECTION _____

Please indicate well location X.

ADDITIONAL INFORMATION

If more than one screen, show locations of each on sketch.