

JACKSON
 J 2015
 3-22-76

MISSISSIPPI
 BOARD OF WATER COMMISSIONERS
 416 North State Street
 Jackson, Mississippi 39201

WATER WELL DRILLERS LOG
 COASTAL DRILLING & SERVICE CO.

3/22/76
 date well completed

ROUTE 1 BOX 618

Jackson
 county well located

LANDOWNER: *Mattie Ford*
 Rt 5-St-Martin-Ball
 Ocean Spring Miss
 (mailing address)

description of formations encountered	from	to
Top Soil	1	3
Red Clay	3	15
White Sand	15	45
Soft Blue Clay	45	200
Med hard Blue Clay	200	270
White Sand	270	285
Soft Blue Clay	285	315
Hard Blue Clay	315	370
Hard Blue Clay	370	400
Free water sand	400	410
Free water sand	410	440

WELL LOCATION:
 sec 35 T 6 N R 9 E
 2 1/2 miles S of Lumberton
 (distance) (direction) (nearest town)

WELL PURPOSE: *Ball pond*
 (home, irrigation, municipal, industrial)

WELL COMPLETION DATA:

(1) diameter (inches) 2"

(2) total depth (feet) 440'

(3) static water level (feet) 25 below above top of ground.

(4) casing PVC 430'
 (material) (depth)

(5) screen 10' 430'
 (length) (depth to top)

2" PVC
 (size) (material)

(6) pump One 15
 (HP) (yield gpm)

Ele
 (type power)

(7) electric log no
 (yes or no)

(organization running log)


(8) how well bottom plugged
2" barbed wire

DRILLERS REMARKS:
good well

MAR 31 1976
 MISS. BD. OF WATER COMMISSIONERS

If well telescopes please sketch and show depths.

GROUND LEVEL

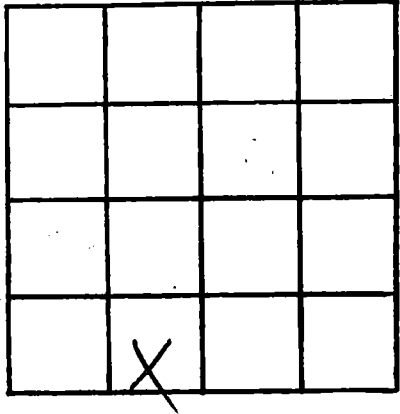

SECTION _____

Please indicate well location X.

ADDITIONAL INFORMATION

If more than one screen, show locations of each on sketch.