

Jackson  
J 2016  
July 6, 1976

MISSISSIPPI  
 BOARD OF WATER COMMISSIONERS  
 416 North State Street  
 Jackson, Mississippi 39201

WATER WELL DRILLERS LOG

7/6  
 date well completed

19 76 Coast Water Well Service  
 firm name

Jackson  
 county well located

LANDOWNER: Tracy Webb  
469 Leckich Ave.  
North Biloxi  
 (mailing address)

WELL LOCATION:  
 sec. 13 T. 6 N. R. 9 E.  
8 miles North of Ocean Springs  
 (distance) (direction) (nearest town)

WELL PURPOSE: Home  
 (home, irrigation, municipal, industrial)

WELL COMPLETION DATA:  
 (1) diameter (inches) 2"  
 (2) total depth (feet) 210'  
 (3) static water level (feet) 30' below above top of ground.  
 (4) casing pvc, 300'  
 (material) (depth)  
2" if telescope see back.  
 (size)  
 (5) screen 10', 200'  
 (length) (depth to top)  
2", p.v.c.  
 (size) (material)  
 (6) pump 1 9  
 (HP) (yield gpm)  
electric  
 (type power)  
 (7) electric log \_\_\_\_\_  
 (yes or no)  
 \_\_\_\_\_  
 (organization running log)  
 (8) how well bottom plugged 1 B/w  
valve

description of formations encountered	from	to
<u>Top Soil</u>	<u>0</u>	<u>2</u>
<u>Red Clay</u>	<u>2</u>	<u>21</u>
<u>Med. Sand</u>	<u>21</u>	<u>40</u>
<u>Blue Clay</u>	<u>40</u>	<u>81</u>
<u>Med. Sand</u>	<u>81</u>	<u>145</u>
<u>Blue Clay</u>	<u>145</u>	<u>183</u>
<u>Coarse Sand</u>	<u>183</u>	<u>210</u>

**RECEIVED**


JAN 3 1977

DRILLERS REMARKS:

COMM

If well telescopes please sketch and show depths.

GROUND LEVEL

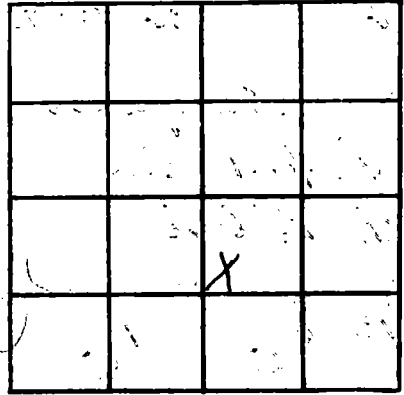

SECTION 8

Please indicate well location X.

ADDITIONAL INFORMATION

If more than one screen, show locations of each on sketch.