

JACKSON
 J 2020
 7-28-76

MISSISSIPPI
 BOARD OF WATER COMMISSIONERS
 416 North State Street
 Jackson, Mississippi 39201

WATER WELL DRILLERS LOG

Jackson
~~Madison~~
 county well located

7/28 1976 ¹³⁵ ~~Pinetop~~ ^{Pineville} Well No. ~~135~~ ¹³⁵
 date well completed firm name

| LANDOWNER: <u>R. Lattimer</u> | description of formations encountered | from | to |
|-------------------------------|---------------------------------------|-----------|------------|
| <u>Lattimer Community</u> | | | |
| (mailing address) | <u>white Clay</u> | <u>0</u> | <u>80</u> |
| | <u>hard blue pipe Clay</u> | <u>80</u> | <u>260</u> |

WELL LOCATION:
 sec 10 T 6 R 9
0 miles N-E of Lattimer
 (distance) (direction) (nearest town)

WELL PURPOSE: home
 (home, irrigation, municipal, industrial)

- WELL COMPLETION DATA:
- (1) diameter (inches) 2"
 - (2) total depth (feet) 280
 - (3) static water level (feet) 25 below top of ground.
 - (4) casing PVC (material), 280 (depth),
2" (size) if telescope see back.
 - (5) screen 10' (length), 270 (depth to top),
2 (size), PVC #40 (material)
 - (6) pump 1 (HP), 15 (yield gpm),
abc (type power)
 - (7) electric log N (yes or no)
 - (organization running log) _____
 - (8) how well bottom plugged _____


DRILLERS REMARKS: _____

RECEIVED
 FEB 11 1977

MISS. BD. OF WATER COMM

If well telescopes please sketch and show depths.

GROUND LEVEL

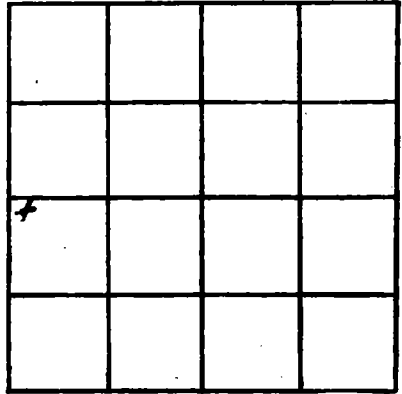

SECTION _____

Please indicate well location X.

ADDITIONAL INFORMATION

If more than one screen, show locations of each on sketch.