

JACKSON
 J 2021
 8/21/76
 8/21/76
 date well completed

MISSISSIPPI
 BOARD OF WATER COMMISSIONERS
 416 North State Street
 Jackson, Mississippi 39201

WATER WELL DRILLERS LOG
 COASTAL DRILLING & SERVICE CO.
 ROUTE 1 BOX 618
 BILOXI, MISS. 39532

Jackson
 county well located

LANDOWNER: W.R. Penner
9617 Blossmond Dr
Biloxi, Miss 39532
 (mailing address)

description of formations encountered	from	to
Top Soil	1	3
Red Clay	3	18
White Sand	18	33
Clay	33	38
Soft Blue Clay	38	60
White Sand	60	110
Soft Blue Clay	110	210
fine water sand	210	230
Hard Blue Clay	230	380
fine water sand	380	405
Coarse Water Sand	405	435

WELL LOCATION:
 sec 27 T 6 S R 9 E
1/2 miles South of Forest
 (distance) (direction) (nearest town)

WELL PURPOSE: Home
 (home, irrigation, municipal, industrial)

WELL COMPLETION DATA:

(1) diameter (inches) 2"

(2) total depth (feet) 435'

(3) static water level (feet) 50' below top of ground

(4) casing PVC, 425'
 (material) (depth)

_____ If telescope see back.
 (size)

(5) screen 10', 425'
 (length) (depth to top)

2", PVC
 (size) (material)

(6) pump one, 12
 (HP) (yield gpm)

9kw
 (type power)

(7) electric log no
 (yes or no)

_____ (organization running log)

(8) how well bottom plugged
2" hard black plastic


DRILLERS REMARKS:

RECEIVED
 AUG 27 1976

MISS. BD. OF WATER COMMISSIONERS

If well telescopes please sketch and show depths.

GROUND LEVEL

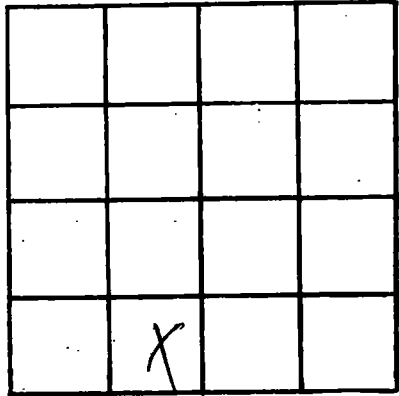

SECTION _____

Please indicate well location X.

ADDITIONAL INFORMATION

A series of 18 horizontal lines for writing additional information.

If more than one screen, show locations of each on sketch.