

JACKSON
 J 2022
 7-30-76

MISSISSIPPI
 BOARD OF WATER COMMISSIONERS
 416 North State Street
 Jackson, Mississippi 39201

WATER WELL DRILLERS LOG

COAST WATER WELL SERVICE INC.

7/30

1976

date well completed

firm name

Jackson

county well located

LANDOWNER

Gary Adams

description of formations encountered.

from

to

Rt 5 Box F-360

Top soil

0 3

Ocean Springs, Miss. 39564
 (mailing address)

Gray clay

3 38

WELL LOCATION:

sec. 36 T 6 N R 8 W

6 miles N.E. of Ocean Springs
 (distance) (direction) (nearest town)

Sand (M)

38 70

WELL PURPOSE:

(home, irrigation, municipal, industrial)

Home

WELL COMPLETION DATA:

- (1) diameter (inches) 2
- (2) total depth (feet) 70'
- (3) static water level (feet) 25 (below top of ground)

- (4) casing P.V.C. 60' (material) (depth)
 2" (size) If telescope see back.

- (5) screen 10' 60' (length) (depth to top)

- (6) pump 1/2 hp. 5 1/2 (HP) (yield gpm)

Elect. (type power)

- (7) electric log No. (yes or no)

(organization running log)

- (8) how well bottom plugged B/w valves

DRILLERS REMARKS:


RECEIVED

MAR - 9 1976

MISS. BD. OF WATER COMM

If well telescopes please sketch and show depths.

GROUND LEVEL

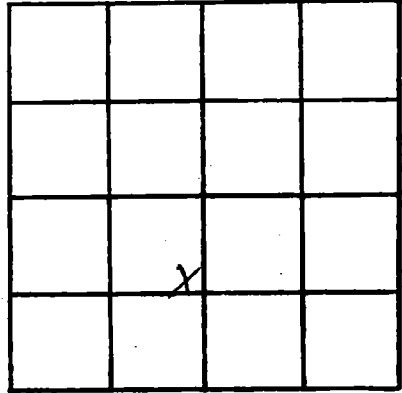

SECTION 36

Please indicate well location X.

ADDITIONAL INFORMATION

If more than one screen, show locations of each on sketch.