

JACKSON  
 J 2024  
 10/7/76

MISSISSIPPI  
 BOARD OF WATER COMMISSIONERS  
 416 North State Street  
 Jackson, Mississippi 39201

WATER WELL DRILLERS LOG  
 COAST WATER WELL SERVICE INC.

10/7 1976 date well completed  
 firm name  
 Jackson county well located

LANDOWNER: Edward Vuyovich  
 Vuyovich  
 525 Reynolds St.  
 Biloxi, Miss. 39530  
 (mailing address)

| description of formations encountered | from to |     |
|---------------------------------------|---------|-----|
|                                       |         |     |
| Top Soil                              | 0       | 3   |
| Red Clay                              | 3       | 23  |
| Sand C (med Sand)                     | 23      | 76  |
| Blue Clay                             | 76      | 140 |
| Med. Sand                             | 140     | 162 |
| Blue Clay                             | 162     | 168 |
| Med. Sand                             | 168     | 190 |

WELL LOCATION:  
 sec. 36 T. 6 R. 8 W. 5  
 6 miles N.E. of Ocean Springs  
 (distance) (direction) (nearest town)

WELL PURPOSE: None  
 (home, irrigation, municipal, industrial)

- WELL COMPLETION DATA:
- (1) diameter (inches) 2"
  - (2) total depth (feet) 190'
  - (3) static water level (feet) 5' below top of ground.
  - (4) casing PVC, 180' (material) (depth)  
 2 (size) If telescope see back.
  - (5) screen 10, 180' (length) (depth to top)  
 2 (size) PVC (material)
  - (6) pump 1/2 hp, 8 1/2 (typ) (yield gpm)  
 Elect. (type power)
  - (7) electric log No (yes or no)
  - (organization running log)
  - (8) how well bottom plugged Blw Valve


DRILLERS REMARKS:

RECEIVED  
 MAR - 9 1977

MISS. Bd. OF WATER COMM.

If well telescopes please sketch and show depths.

GROUND LEVEL

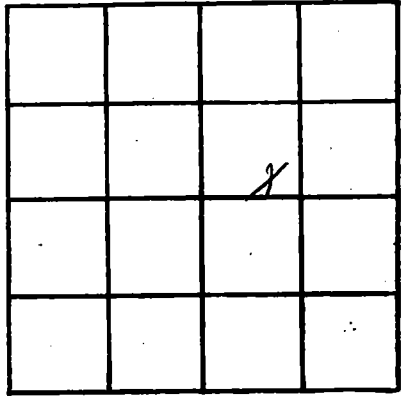

SECTION 36

Please indicate well location X.

ADDITIONAL INFORMATION

If more than one screen, show locations of each on sketch.