

Jackson
 J 2025
 12/12/76

MISSISSIPPI
 BOARD OF WATER COMMISSIONERS
 416 North State Street
 Jackson, Mississippi 39201

WATER WELL DRILLERS LOG

Dec 19
 date well completed

1976 Bryant Well Co.
 firm name

JACKSON
 Hamilton CO
 county well located

LANDOWNER: Albert Reed Jr.
 Rt. 2 Box 332
 Osborn Springs, Mo.
 (mailing address)

description of formations encountered	from	to
clay	0	33
sand	33	92
clay	92	108
sand	118	142
clay	142	170
good sand	170	193

WELL LOCATION:
 sec. 23 T. 6 N. R. 8 E.
 4 miles W of Vandeventer
 (distance) (direction) (nearest town)

WELL PURPOSE: HOME
 (home, irrigation, municipal, industrial)

- WELL COMPLETION DATA:
- (1) diameter (inches) 2"
 - (2) total depth (feet) ~~193~~ 193'
 - (3) static water level (feet) 37 ^{below} above top of ground.
 - (4) casing PVC, 193'
 (material) (depth)
 _____ If telescope see back.
 (size)
 - (5) screen 10', 193'
 (length) (depth to top)
 008, PVC
 (size) (material)
 - (6) pump 1, 8
 (HP) (yield gpm)
 Elctc
 (type power)
 - (7) electric log No
 (yes or no)

 (organization running log)
 - (8) how well bottom plugged Metal
 SAND SHARK


DRILLERS REMARKS:

RECEIVED
 MAR - 7 1977

MISS. BD. OF WATER COMMISSIONERS

If well telescopes please sketch and show depths.

GROUND LEVEL

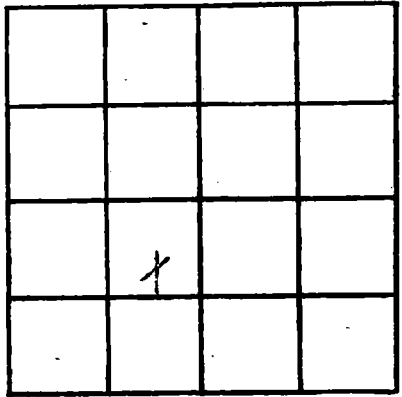

SECTION 23

Please indicate well location X.

ADDITIONAL INFORMATION

If more than one screen, show locations of each on sketch.