

JACKSON  
 J 2077  
 1-20-77

MISSISSIPPI  
 BOARD OF WATER COMMISSIONERS  
 416 North State Street  
 Jackson, Mississippi 39201

WATER WELL DRILLERS LOG  
 COASTAL DRILLING & SERVICE CO.

1/20/77  
 date well completed

ROUTE 1 BOX 618  
 firm name

Jackson  
 county well located

BILOXI MISS. 39532

LANDOWNER: N.R. Crawford  
pt 6 Box 675  
Ocean Springs  
 (mailing address)

description of formations encountered	from	to
Top Soil	1	3
Red Clay	3	30
Coarse white Sand	30	70
Soft Blue Clay	70	215
Hard Blue Clay	215	260
fine water Sand	260	285
Hard Blue Clay	285	420
fine water Sand	420	440
Coarse water Sand	440	525

WELL LOCATION:  
 sec. 8 T. 6 N. R. 8 W.  
3 miles (distance) of W (direction) of W (nearest town)

WELL PURPOSE: home  
 (home, irrigation, municipal, industrial)

WELL COMPLETION DATA:  
 (1) diameter (inches) 4 1/2"  
 (2) total depth (feet) 525'  
 (3) static water level (feet) 70 below top of ground  
 (4) casing glow 490'  
4 1/2" (material) (depth)  
 (size) If telescope see back.  
 (5) screen 15' 490'  
2" (length) (depth to top)  
2" (size) 25 (material)  
 (6) pump one 20  
Ele (HP) (yield gpm)  
 (type power)  
 (7) electric log no  
 (yes or no)

(organization running log)

(8) how well bottom plugged 24  
back with stone

DRILLERS REMARKS:

RECEIVED  
 FEB - 4 1977

MISS. BD. OF WATER COMM

If well telescopes please sketch and show depths.

GROUND LEVEL


160' 4" ~~Alum~~  
Casing

330 2" galv  
Casing

15' 2" SS screen

2" backwash  
Valve

If more than one screen,  
show locations of each on sketch.

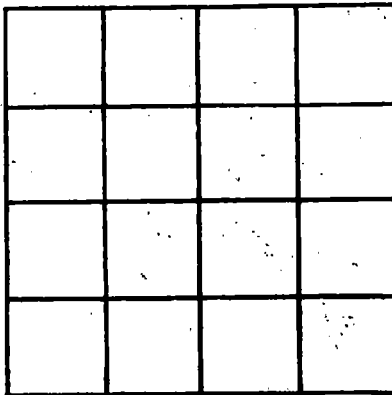

SECTION \_\_\_\_\_

Please indicate well location X.

ADDITIONAL INFORMATION

Lined area for additional information.