

JACKSON  
 J 2029  
 2-22-77

MISSISSIPPI  
 BOARD OF WATER COMMISSIONERS  
 416 North State Street  
 Jackson, Mississippi 39201

WATER WELL DRILLERS LOG

2-22 date well completed      1977 Coast Water Well Serv. firm name      Jackson county well located

LANDOWNER: A. D. Spivey  
P.O. Box 898  
Houston, Mo. 39553  
 (mailing address)

WELL LOCATION:  
 sec. 3 T. 6 N. R. 8 W.  
6 miles W of Vanhook  
 (distance) (direction) (nearest town)

WELL PURPOSE: Home  
 (home, irrigation, municipal, industrial)

WELL COMPLETION DATA:

(1) diameter (inches) 2"

(2) total depth (feet) 932'

(3) static water level (feet) 27 below top of ground.

(4) casing PVC, 917'  
 (material) (depth)  
2" if telescope see back.  
 (size)

(5) screen 15', 917'  
 (length) (depth to top)  
2", PVC  
 (size) (material)

(6) pump 1 10  
 (HP) (yield gpm)  
Elec.  
 (type power)

(7) electric log NO  
 (yes or no)

(organization running log)

(8) how well bottom plugged Blue Valve

description of formations encountered	from	to
top soil	0	35
fine sand	35	50
yellow clay	50	82
med to coarse sand	82	180
blue clay	180	339
fine sand	339	350
blue clay	350	410
fine sand	410	418
blue clay	418	515
fine sand	515	521
blue clay	521	600
fine sand	600	612
blue clay	612	670
fine sand	670	690
blue clay	690	832
med to coarse sand	832	932


RECEIVED  
 MAR 11 1977

DRILLERS REMARKS:

MISS. BD. OF WATER COMMISSIONERS

If well telescopes please sketch and show depths.

GROUND LEVEL

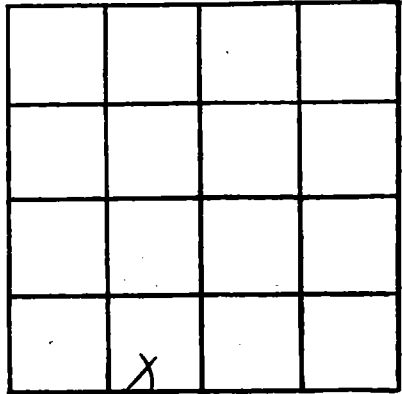

SECTION 3

Please indicate well location X.

ADDITIONAL INFORMATION

If more than one screen, show locations of each on sketch.