

Jackson
 J 2030
 2-22-77

MISSISSIPPI
 BOARD OF WATER COMMISSIONERS
 416 North State Street
 Jackson, Mississippi 39201

WATER WELL DRILLERS LOG

2-22-77
 date well completed

130

COAST WATER WELL SERVICE

firm name

Jackson
 county well located

LANDOWNER: Roy Hester
 Rt 2
 Ocean Springs, Miss.
 (mailing address) 39564

description of formations encountered

from

to

WELL LOCATION:
 sec 3 T 6 S R 8 W
 5 1/2 miles W of Ocean Springs
 (distance) (direction) (nearest town)

Top soil 0 35

Med sand 35 72

Blue Clay 72 92

fine to coarse sand 92 164

Blue Clay 164 205

fine to coarse sand 205 250

Blue Clay 250 400

fine sand 400 410

Blue Clay 410 465

fine to coarse 465 497

WELL PURPOSE: Home
 (home, irrigation, municipal, industrial)

WELL COMPLETION DATA:

- (1) diameter (inches) 2
- (2) total depth (feet) 497
- (3) static water level (feet) 76 below top of ground
- (4) casing P.V.C. 487 (material) (depth)
- 2 (size) if telescope see back.
- (5) screen 10 (length) 487 (depth to top)
- 2 (size) P.V.C. (material)
- (6) pump 2 hp (HP) 6'12 (yield gpm)
- elect. (type power)
- (7) electric log No. (yes or no)

(organization running log)

(8) how well bottom plugged Backwash Valve


RECEIVED
 MAR - 9 1977

DRILLERS REMARKS:

MISS. BD. OF WATER COMMISSIONERS

If well telescopes please sketch and show depths.

GROUND LEVEL

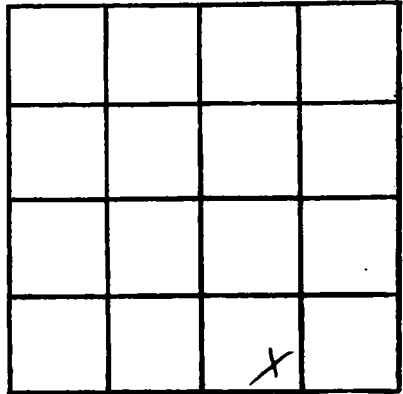

SECTION 3

Please indicate well location X.

ADDITIONAL INFORMATION

A series of horizontal lines for additional information.

If more than one screen, show locations of each on sketch.