

JACKSON
 J 2082
 3-8-77

MISSISSIPPI
 BOARD OF WATER COMMISSIONERS
 416 North State Street
 Jackson, Mississippi 39201

WATER WELL DRILLERS LOG
 COASTAL DRILLING & SERVICE CO.

3/8/77 19 date well completed
 ROUTE 1 BOX 618 Wm name
 BILOXI MISS 39532 county well located

LANDOWNER: Paul Magallon
 Rt 3 Box 618
 Ocean Springs Miss
 (mailing address)

description of formations encountered	from	to
Top Soil	1	3
Red Clay	3	15
Sandy Sand	15	45
Coarse White Sand	45	120
Soft Blue Clay	120	210
Hard Water Sand	210	225
Hard Blue Clay	225	410
fine water sand	410	420
Coarse Water sand	420	440

WELL LOCATION:
 sec 35 T. 10 S. R. 9 E
 (3) South Latimer
 (distance) (direction) (nearest town)

WELL PURPOSE: home
 (home, irrigation, municipal, industrial)

- WELL COMPLETION DATA:
- (1) diameter (inches) 4 1/2"
 - (2) total depth (feet) 448'
 - (3) static water level (feet) 40 below top of ground
 - (4) casing PVC 433' (material) (depth)
 4 1/2" (size) if telescope see back.
 - (5) screen 15' 433' (length) (depth to top)
 2" (size) PVC (material)
 - (6) pump One SD 20 (HP) (yield gpm)
 5hp (type power)
 - (7) electric log No (yes or no)

(organization running log)

(8) how well bottom plugged
 Plug with Gravel

DRILLERS REMARKS:

RECEIVED
 JUN 16 1977

MISS. BD. OF WATER COMM

If well telescopes please sketch and show depths.

GROUND LEVEL

160' 4" PVC Casing




273' 2" PVC Casing

15ft 3" PVC screen

2" backwash valve

If more than one screen, show locations of each on sketch.

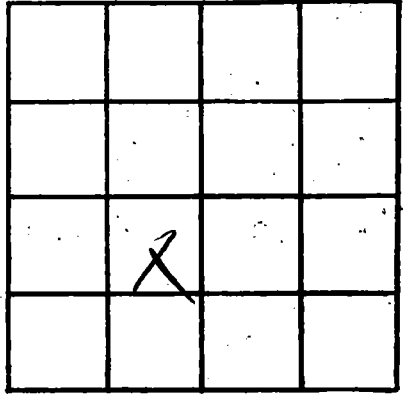

SECTION _____

Please indicate well location X.

ADDITIONAL INFORMATION

Multiple horizontal lines for providing additional information.