

Jackson  
 J 2036  
 5/10/77

MISSISSIPPI  
 BOARD OF WATER COMMISSIONERS  
 416 North State Street  
 Jackson, Mississippi 39201

WATER WELL DRILLERS LOG  
 COASTAL DRILLING & SERVICE CO.

5/10 1977 date well completed  
 ROUTE 1 BOX 618  
 Biloxi, Miss. 39532  
 Jackson county well located

LANDOWNER

Charles R. Kelly

description of formations encountered

from to

Rt 3 Box 640 B  
 Ocean Springs, Miss  
 (mailing address)

Top Soil	1	3
Red Clay	3	15
White Sand	15	120
S. Ft. Blue Clay	120	200
White Sand	200	240
S. Ft. Blue Clay	240	300
White Sand	300	320
Light Blue Clay	320	410
Light Blue Sand	410	425
Hard Blue Clay	425	600
Red	600	602
Hard Blue Clay	602	700
Fine Water Sand	700	710
Coarse Water Sand	710	765

WELL LOCATION:

sec 23 T 6 S R 8 W  
 (4) 1/2 miles (distance) of Vandeventer (direction) of (nearest town)

WELL PURPOSE:

(home, irrigation, municipal, industrial)

WELL COMPLETION DATA:

- (1) diameter (inches) 2"
- (2) total depth (feet) 745'
- (3) static water level (feet) 8' below top of ground
- (4) casing PVC 735' (material) (depth)
- (5) screen 10' 735' (length) (depth to top)  
 2" (size) PVC (material)
- (6) pump 1/2 (HP) 15 (yield gpm)  
 Etc (type power)
- (7) electric log no (yes or no)

(organization running log)

(8) how well bottom plugged


DRILLERS REMARKS:  
 Very good well

RECEIVED  
 JUN 16 1977

MISS. BR. OF WATER GAMM

If well telescopes please sketch and show depths.

GROUND LEVEL

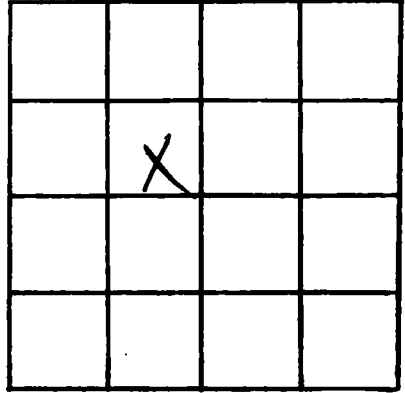

SECTION \_\_\_\_\_

Please indicate well location X.

ADDITIONAL INFORMATION

If more than one screen, show locations of each on sketch.