

JACKSON  
 J 20 1977  
 8-1-77

MISSISSIPPI  
 BOARD OF WATER COMMISSIONERS  
 416 North State Street  
 Jackson, Mississippi 39201

WATER WELL DRILLERS LOG

Aug 1 1977 Duncan Well Drilling Jackson  
 date well completed firm name county well located

LANDOWNER: <u>Ken Jalencich</u>	description of formations encountered	from	to
<u>Rt. 5 Box 234</u>			
<u>Deer Springs, Ms. 39564</u> (mailing address)	<u>Blue Clay</u>	<u>5</u>	<u>18</u>
	<u>Sand</u>	<u>18</u>	<u>40</u>
	<u>Blue Clay</u>	<u>40</u>	<u>230</u>
	<u>Fine Sand</u>	<u>230</u>	<u>250</u>
	<u>Blue Clay</u>	<u>250</u>	<u>355</u>
	<u>Fine Sand</u>	<u>355</u>	<u>380</u>
	<u>Coarse Sand</u>	<u>380</u>	<u>398</u>

WELL LOCATION:

sec 14 T 6N R 9E  
1/2 miles SE of Latorna  
 (distance) (direction) (nearest town)

WELL PURPOSE: Home  
 (home, irrigation, municipal, industrial)

WELL COMPLETION DATA:

- (1) diameter (inches) 2"
- (2) total depth (feet) 398'
- (3) static water level (feet) 55'  below  above top of ground.
- (4) casing pvc, 398'  
 (material) (depth)
- if telescope see back.  
 (size)
- (5) screen 10', 398'  
 (length) (depth to top)
- 2", pvc sch. 40  
 (size) (material)
- (6) pump 1, 10  
 (HP) (yield gpm)
- electric  
 (type power)
- (7) electric log no  
 (yes or no)

(organization running log)

(8) how well bottom plugged Sand  
Shark

DRILLERS REMARKS:


**RECEIVED**

DEC 1 1977

MISSISSIPPI BOARD OF WATER COMMISSIONERS

If well telescopes please sketch and show depths.

GROUND LEVEL

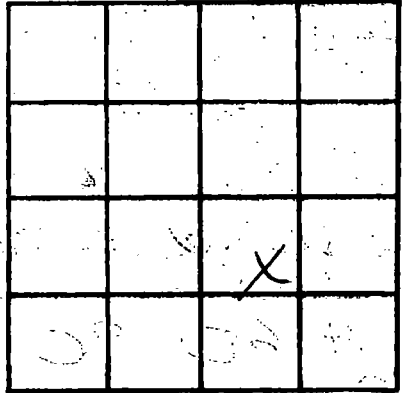

SECTION 14

Please indicate well location X.

ADDITIONAL INFORMATION

If more than one screen, show locations of each on sketch.