

Jackson
 J 2851
 12/12/77

MISSISSIPPI
 BOARD OF WATER COMMISSIONERS
 416 North State Street
 Jackson, Mississippi 39201

WATER WELL DRILLERS LOG

12/12/77 19 Coastal Drilling Jackson
 date well completed firm name county well located
Ballard (city)

LANDOWNER: T.F. Meyer
P.O. 549
Olden Spring, Miss
 (mailing address)

description of formations encountered	from	to
Top Soil	1	3
Red Clay	3	15
White Sandstone	15	40
5 ft Blue Clay	40	100
fine white sand	100	180
5 ft Blue Clay	180	290
hard blue clay	290	490
5 ft Blue Clay	490	525
Coal water sand	525	540

WELL LOCATION:
 sec. 25 T. 6 N. R. 8 E
Four Miles SW Venebaue
 (distance) (direction) (nearest town)

WELL PURPOSE: home
 (home, irrigation, municipal, industrial)

WELL COMPLETION DATA:

(1) diameter (inches) 2"

(2) total depth (feet) 540'

(3) static water level (feet) 40 below
 top of ground.

(4) casing PVC 530'
 (material) (depth)

 if telescope see back.
 (size)

(5) screen 10' 530'
 (length) (depth to top)

2" PVC
 (size) (material)

(6) pump one 10
 (HP) (yield gpm)


5hp
 (type power)

(7) electric log no
 (yes or no)

 (organization running log)

(8) has well bottom plugged
2" beach with valve

DRILLERS REMARKS:

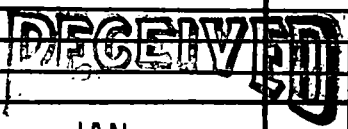

JAN 16 1978

If well telescopes please sketch and show depths.

GROUND LEVEL

SECTION

Please indicate well location X.

ADDITIONAL INFORMATION

If more than one screen, show locations of each on sketch: