

JACKSON

J 2055

MISSISSIPPI  
BOARD OF WATER COMMISSIONERS  
416 North State Street  
Jackson, Mississippi 39201

WATER WELL DRILLERS LOG

3-18-78 date well completed  
19 Crest Water Well Serv. Inc. firm name  
Jackson county well located

LANDOWNER Ernest Apple White  
P.O. Box 2115  
Lascayo, Miss. 39567  
(mailing address)

WELL LOCATION:  
sec. 36 T-6 R-9  
5 miles North of Ocean Springs  
(distance) (direction) (nearest town)

WELL PURPOSE:  
(home, irrigation, municipal, industrial)

WELL COMPLETION DATA:

(1) diameter (inches) 2"

(2) total depth (feet) 650'

(3) static water level (feet) 40' below top of ground

(4) casing P.V.C. 630' (material) (depth)  
2" (size) if telescope see back.

(5) screen 20' 630' (length) (depth to top)  
2 (size) P.V.C. (material)

(6) pump 1 1/2 HP 12 (HP) (yield gpm)  
Electric (type power)

(7) electric log No (yes or no)

(organization running log)

(8) how well bottom plugged  
Back Wash Water

DRILLERS REMARKS:

| description of formations encountered | from | to  |
|---------------------------------------|------|-----|
| Top soil sand                         | 0    | 5   |
| Blue Clay                             | 5    | 190 |
| Sand (F)                              | 190  | 205 |
| Blue Clay                             | 205  | 298 |
| Sand (M)                              | 298  | 312 |
| Blue Clay                             | 312  | 610 |
| Sand (M)                              | 610  | 650 |


RECEIVED

MAY 30 1978

MISS. BD. OF WATER COMMISSIONERS

If well telescopes please sketch and show depths.

GROUND LEVEL

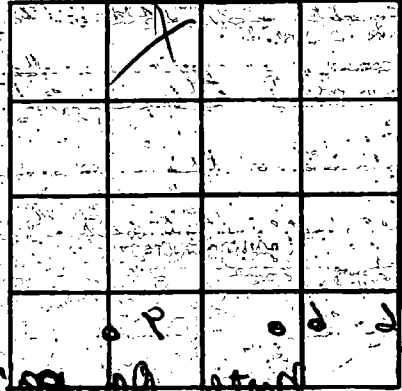

SECTION 36

Please indicate well location X.

ADDITIONAL INFORMATION

If more than one screen, show locations of each on sketch.