

MISSISSIPPI DEPARTMENT OF NATURAL RESOURCES

Bureau of Land and Water Resources

Southport Mall

P.O. Box 10631

Jackson, Mississippi 39209

WATER WELL DRILLERS LOG

JACKSON
J
52057

27 June 86 19
 date well completed

McMill Pump & Well
 firm name

Jackson
 county well located

LANDOWNER: Thurine Baker
 (mailing address)

description of formations encountered	from	to
Sand + mud	0	60
mud	60	250
Sand + mud	250	380
mud	380	680
Sand	680	750

WELL LOCATION:
 sec. 2 T 6 N R 9 E
 (distance) miles (direction) of Acson Springs
 (nearest town)

WELL PURPOSE: home
 (home, irrigation, municipal, industrial)

- WELL COMPLETION DATA:
- (1) diameter (inches) 4" X 2"
 - (2) total depth (feet) 750'
 - (3) static water level (feet) 20' ^{below} above top of ground
 - (4) casing PVC, 730'
 (material) (depth)
4x2 If telescope see back.
 (size)
 - (5) screen 20', bottom
 (length) (depth to top)
2", PVC
 (size) (material)
 - (6) pump 1.5-hp, 25
 (HP) (yield gpm)
Electric
 (type power)
 - (7) electric log NO
 (yes or no)
 (organization running log)
 - (8) how well bottom plugged Seal

RECEIVED

AUG 7 1986

Department of Natural Resources
 Bureau of Land & Water Resources

DRILLERS REMARKS:

If well telescopes please sketch and show depths.


GROUND LEVEL

220'

530'

4" Top

2' Bottom

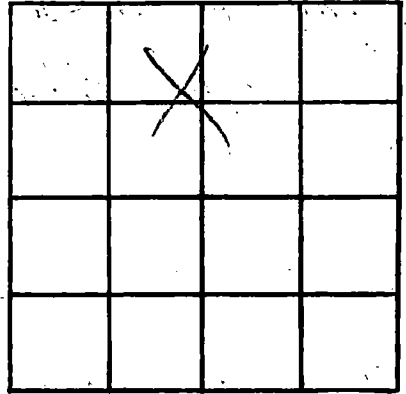

SECTION _____

Please indicate well location X.

ADDITIONAL INFORMATION

If more than one screen, show locations of each on sketch.